
PLAT OF SURVEY FOR JOE TIERNAN
OF LOT-8, BLOCK-1, ADKISON ADDITION
TO THE CITY OF WINTERSET, MADISON COUNTY, IOWA

FILED NO. 307
BOOK 2 PAGE 11
TOWN PLAT
1986 AUG 13 AM 10:47
MARY E. WELTY
RECORDER
MADISON COUNTY, IOWA
Fee $5.00

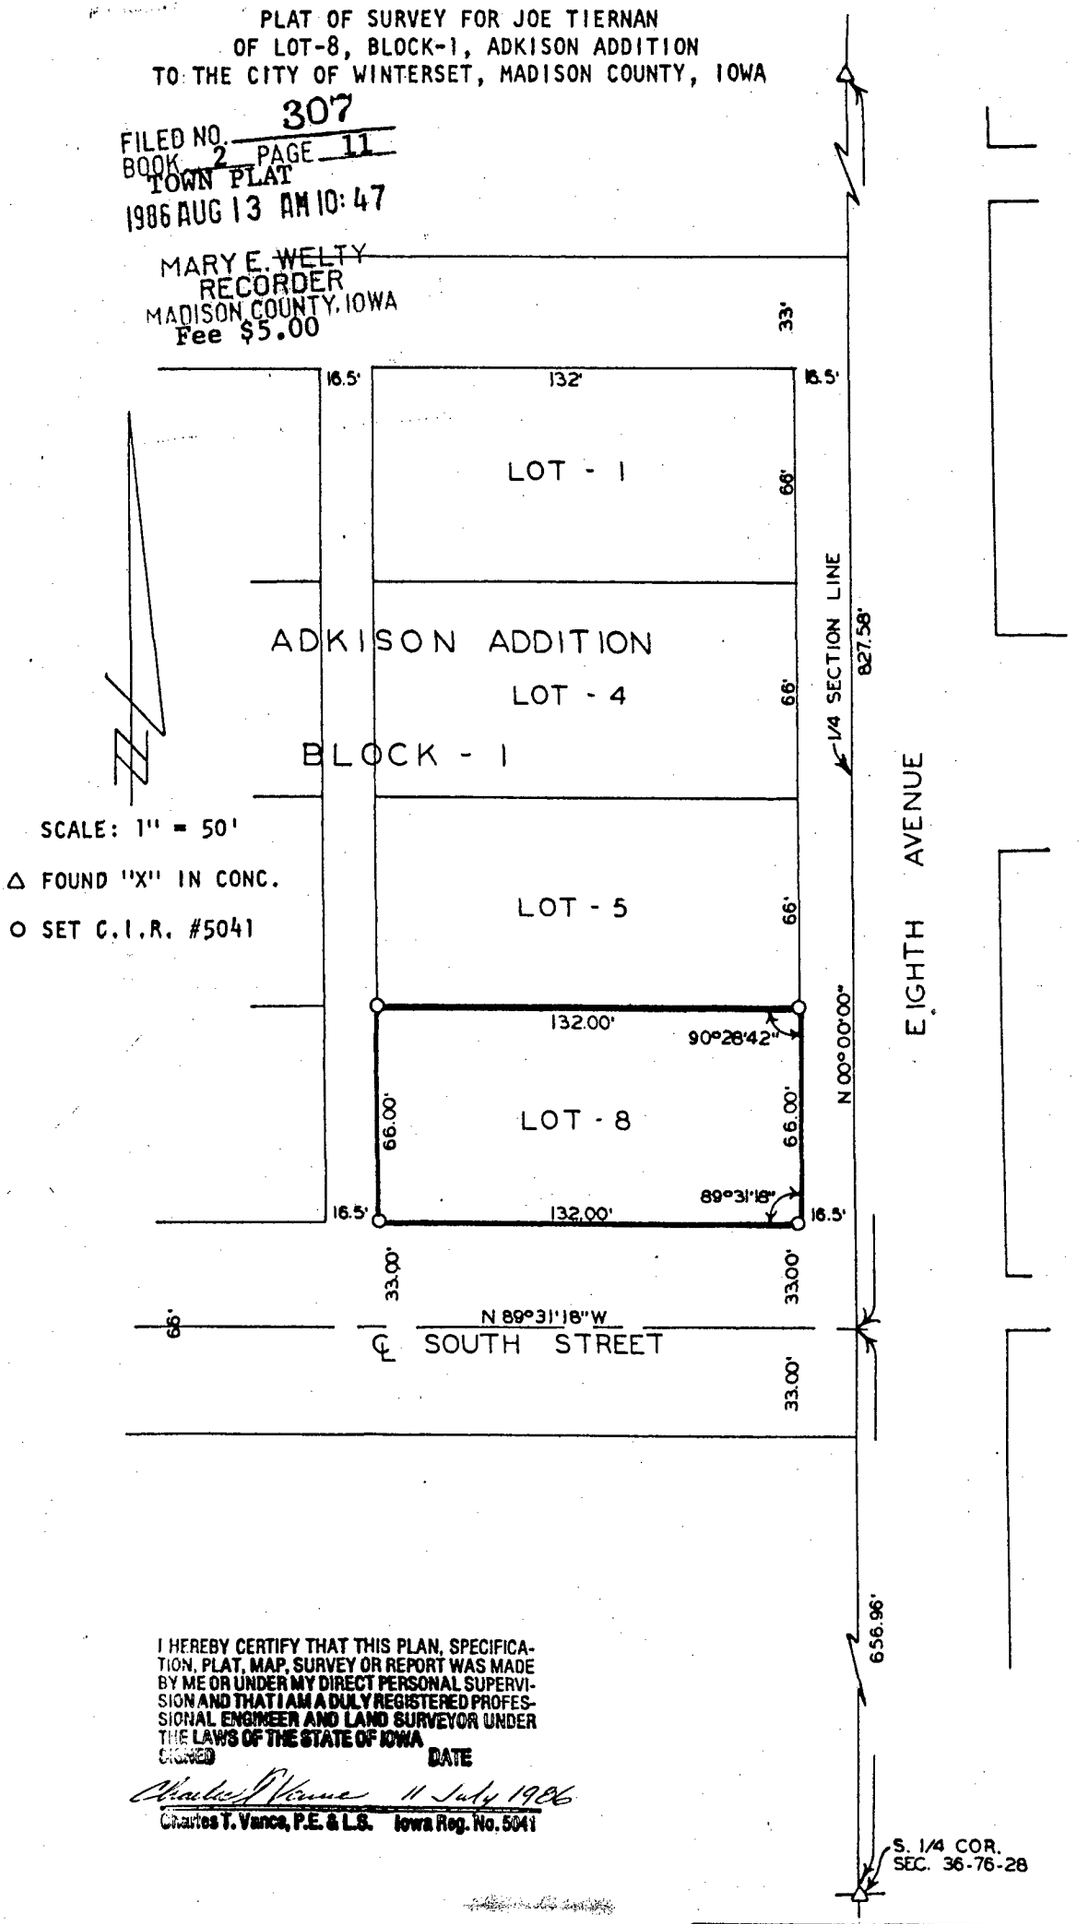

SCALE: 1" = 50'

△ FOUND "X" IN CONC.

○ SET C.I.R. #5041

I HEREBY CERTIFY THAT THIS PLAN, SPECIFICATION, PLAT, MAP, SURVEY OR REPORT WAS MADE BY ME OR UNDER MY DIRECT PERSONAL SUPERVISION AND THAT I AM A DULY REGISTERED PROFESSIONAL ENGINEER AND LAND SURVEYOR UNDER THE LAWS OF THE STATE OF IOWA

SIGNED Charles T. Vance DATE 11 July 1986

Charles T. Vance, P.E. & L.S. Iowa Reg. No. 5041

VANCE & HOCHSTETLER, P.C.
CONSULTING ENGINEERS
71 JEFFERSON STREET
WINTERSET, IOWA 50273