
12

TOWN PLAT 2

PLAT OF SURVEY FOR LAMONT THORPE OF LOT 8 AND THE EAST HALF OF LOT 10, DEPOT ADDITION TO THE CITY OF WINTERSET, MADISON COUNTY, IOWA

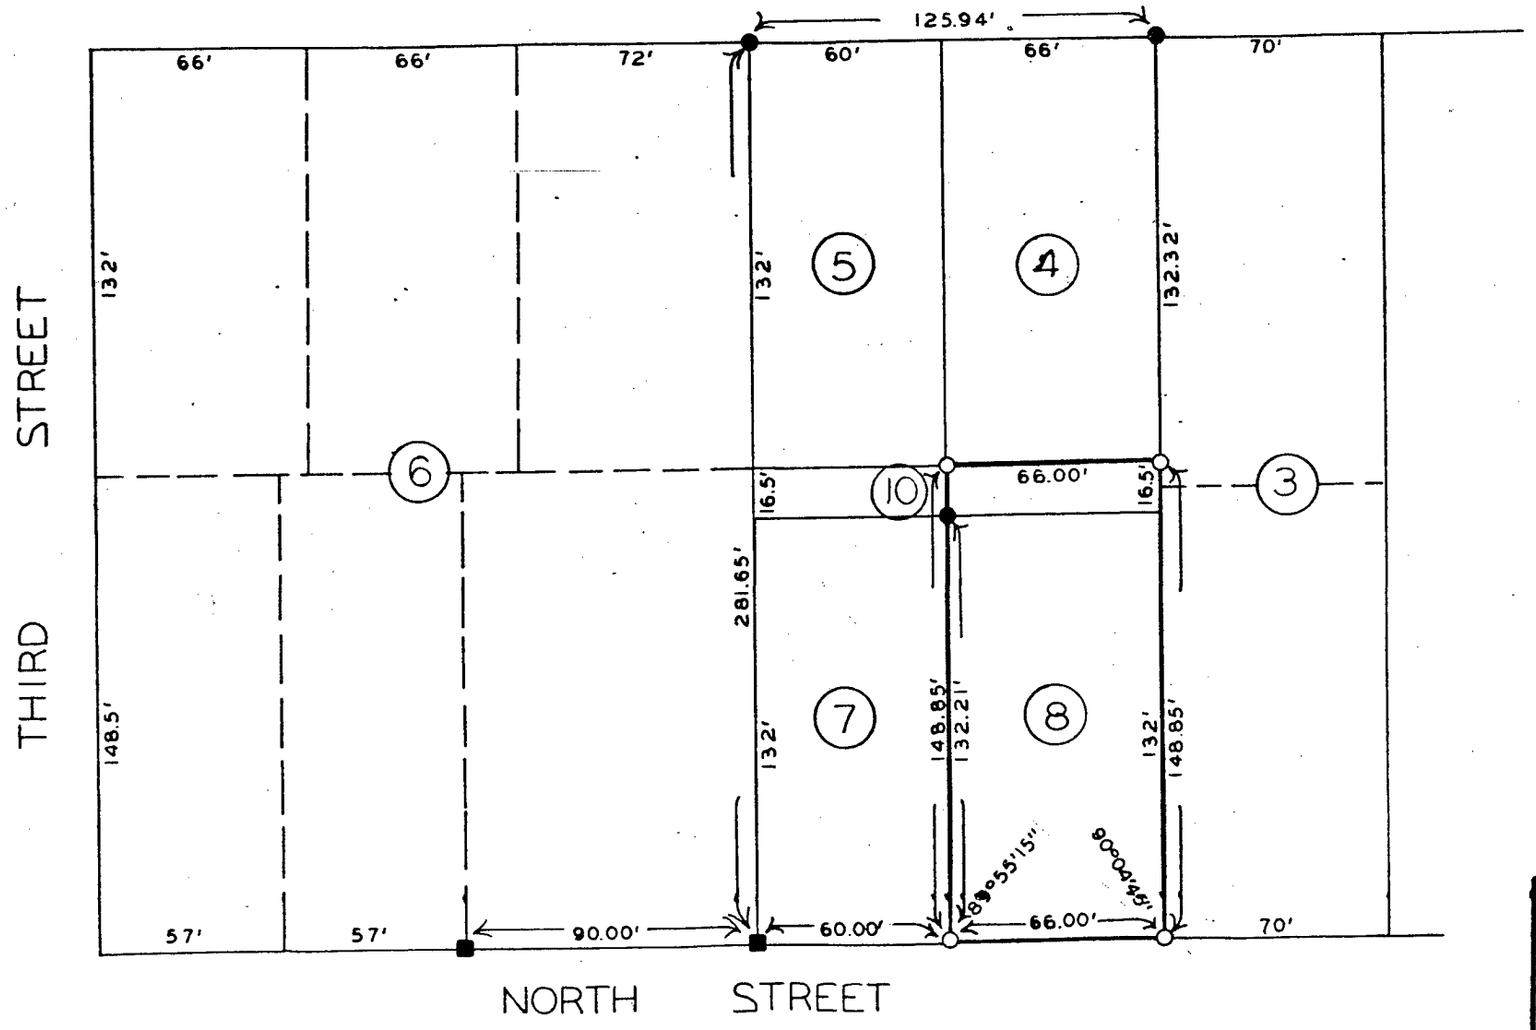

FILED NO. 607
BOOK 2 PAGE 12
TOWN PLAT
1986 SEP 24 AM 11:26

MARY E. WELTY
RECORDER
MADISON COUNTY, IOWA
Fee $8.00

SCALE: 1" = 50'

● FOUND C.I.R. #8034

■ FOUND C.I.R. #5041

○ SET C.I.R. #5041

I HEREBY CERTIFY THAT THIS PLAN, SPECIFICATION, PLAT, MAP, SURVEY OR REPORT WAS MADE BY ME OR UNDER MY DIRECT PERSONAL SUPERVISION AND THAT I AM A DULY REGISTERED PROFESSIONAL ENGINEER AND LAND SURVEYOR UNDER THE LAWS OF THE STATE OF IOWA

SIGNED DATE

Charles T. Vance 10 Sept. 1986

Charles T. Vance, P.E. & L.S. Iowa Reg. No. 5041

VANCE & HOCHSTETLER, P.C.
CONSULTING ENGINEERS
WINTERSET, IOWA 50273