
Plat of Survey for John Baker of Lot 5, Block 3, North Addition to the City of Winterset, Madison County, Iowa.

FILED NO. 969
BOOK 2 PAGE 15
TOWN PLAT
1986 NOV 13 AM 9:38

MARY E. WELTY
RECORDER
MADISON COUNTY, IOWA
Fee $5.00

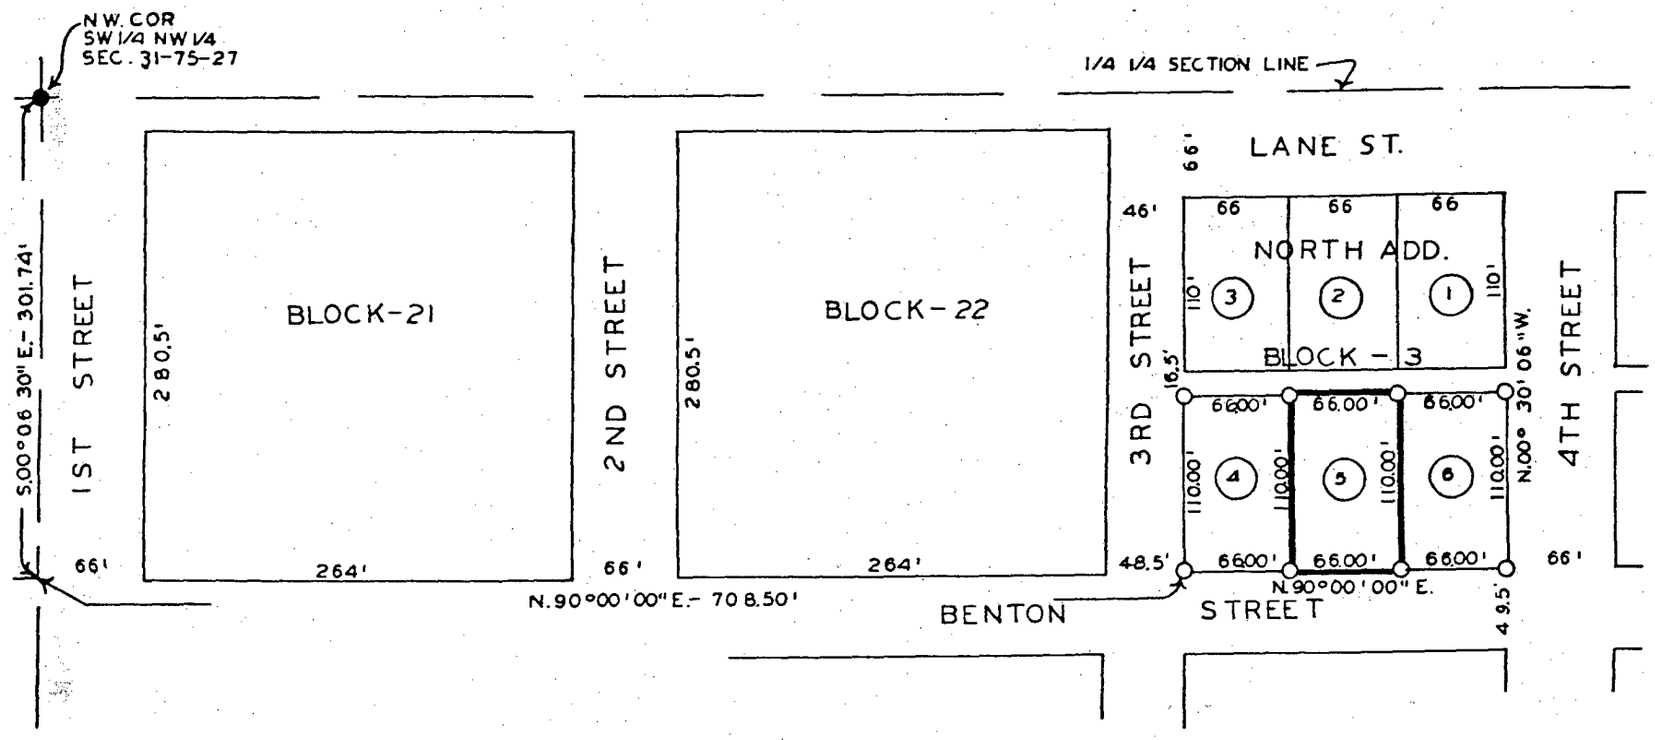

SCALE 1" = 100'
● FOUND D.O.T. PLUG
O SET C.I.R.#5041

I HEREBY CERTIFY THAT THIS PLAN, SPECIFICATION, PLAT, MAP, SURVEY OR REPORT WAS MADE BY ME OR UNDER MY DIRECT PERSONAL SUPERVISION AND THAT I AM A DULY REGISTERED PROFESSIONAL ENGINEER AND LAND SURVEYOR UNDER THE LAWS OF THE STATE OF IOWA

DATE

Charles T. Vance 14 Oct. 1986

Charles T. Vance, P.E. & L.S. Iowa Reg. No. 5041

VANCE & HOCHSTETLER, P.C.
CONSULTING ENGINEERS
WINTERSET, IOWA 50273