


PLAT OF A SURVEY MADE FOR RAY CHAPMAN IN LOTS 2 AND 3,
LINDSEY'S ADDITION TO THE CITY OF WINTERSET, MADISON COUNTY, IOWA.

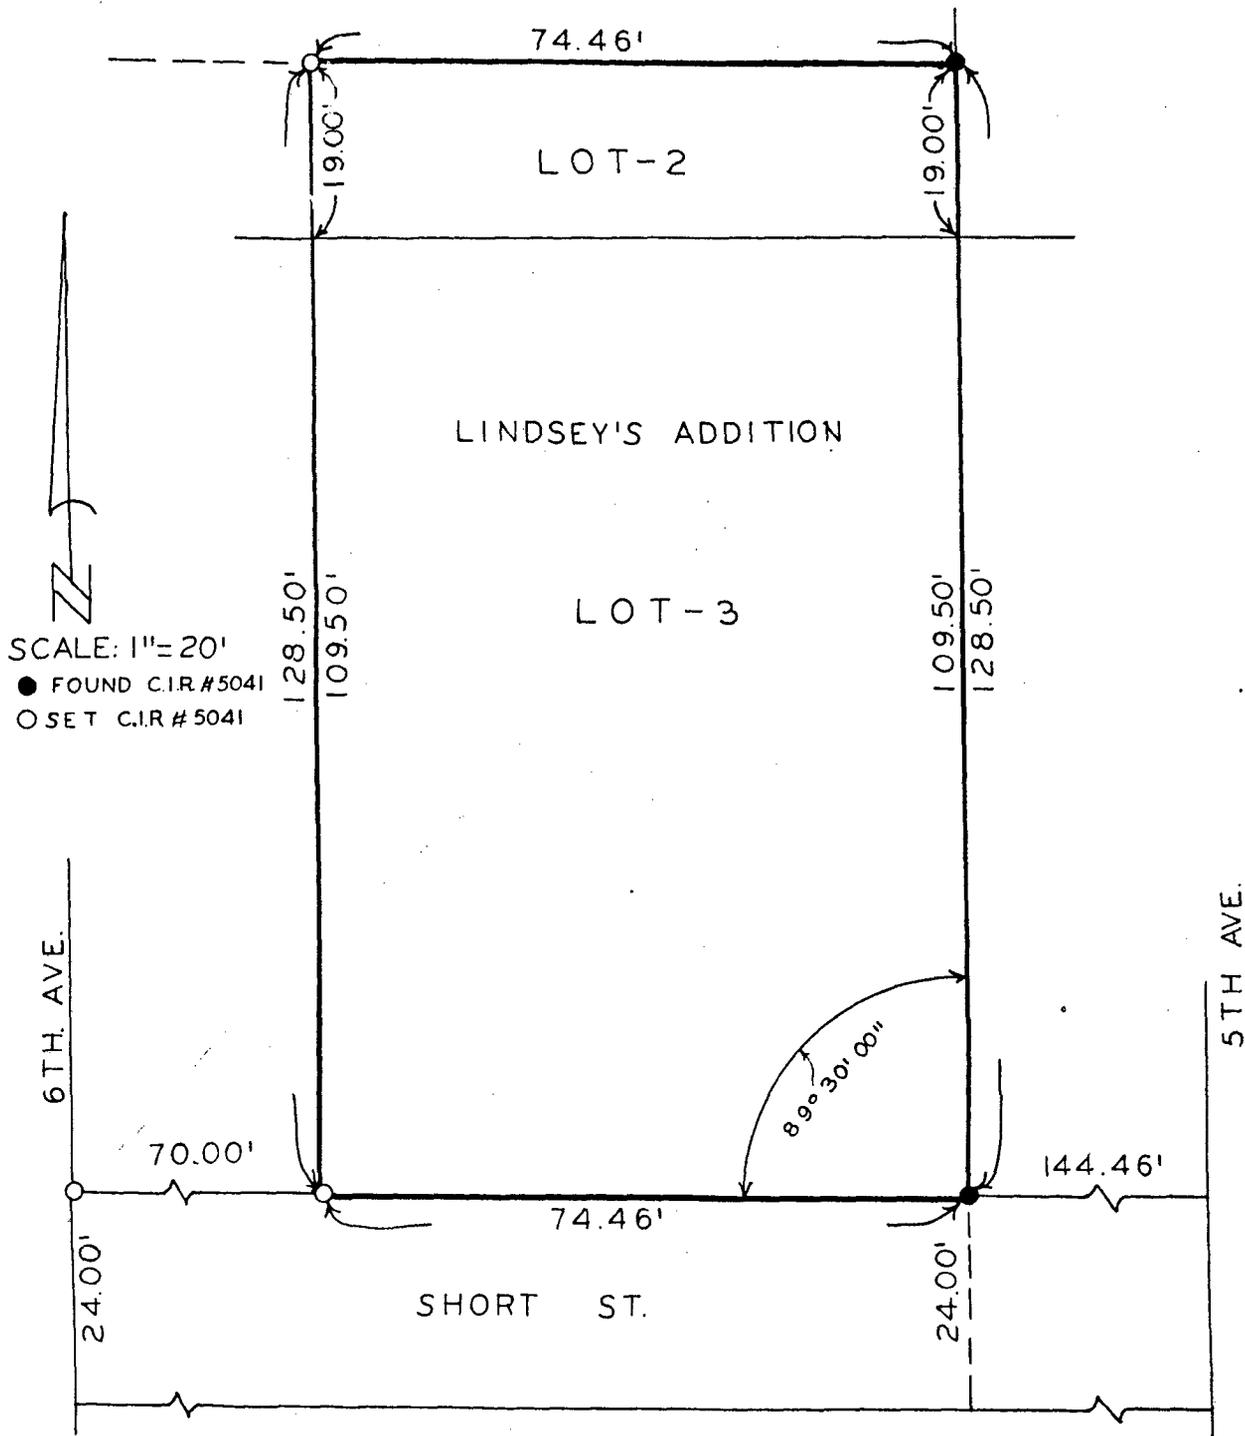

DESCRIPTION:

The East 74.46 feet of the west half (1/2) of Lot 3, except the South 24.00 feet thereof; and the East 74.46 feet of the South 19.00 feet of the west half (1/2) of Lot 2, Lindsey's Addition to the City of Winterset, Madison County, Iowa.

FILED NO. **2357**
BOOK 2 PAGE 20
TOWN PLAT
1987 MAY 26 AM 9:30

I HEREBY CERTIFY THAT THIS PLAN, SPECIFICATION, PLAT, MAP, SURVEY OR REPORT WAS MADE BY ME OR UNDER MY DIRECT PERSONAL SUPERVISION AND THAT I AM A DULY REGISTERED PROFESSIONAL ENGINEER AND LAND SURVEYOR UNDER THE LAWS OF THE STATE OF IOWA
SIGNED Charles T. Vance DATE 29 April 1987
Charles T. Vance, P.E. & L.S. Iowa Reg. No. 5541

IND
REC
PAGE

MARY E. WELTY
RECORDER
MADISON COUNTY, IOWA
Fee \$5.00

VANCE & HOCHSTETLER, P.C.
CONSULTING ENGINEERS
71 JEFFERSON STREET
WINTERSET, IOWA 50273