PLAT OF SURVEY FOR LARRY VOWELL
OF LOT 2, BLOCK 1, WEST ADDITION
TO THE CITY OF WINTERSET, IOWA

FILED NO. 61
BOOK 2 PAGE 27
Town Plat
1987 JUL 14 PM 1:18
MARY E. WELTY
RECORDER
MADISON COUNTY IOWA
Fee $5.00

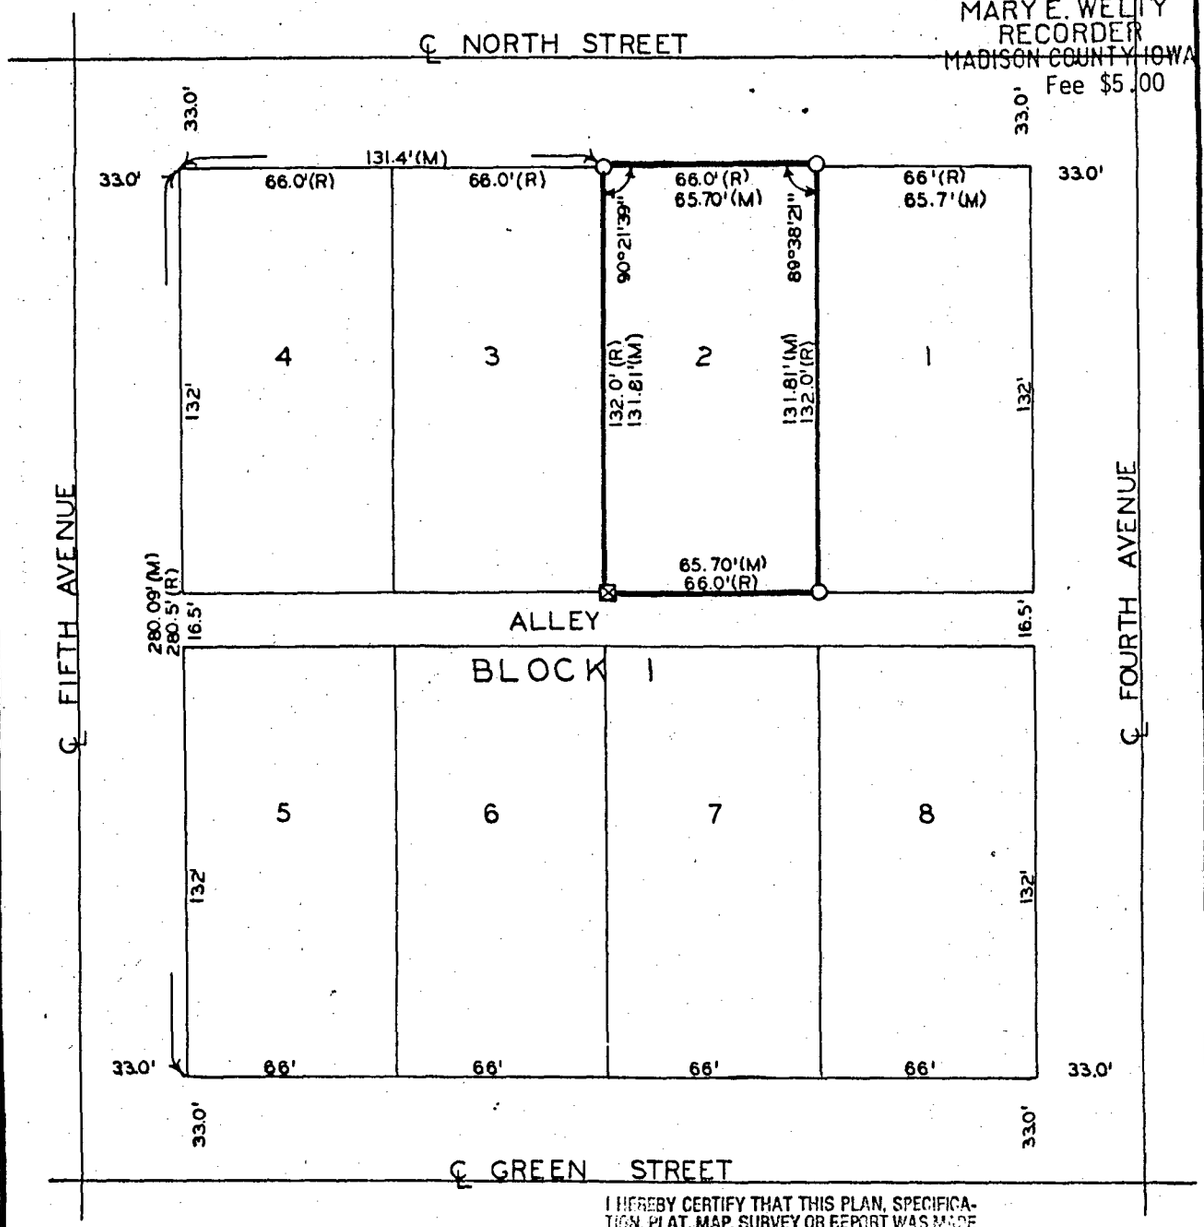

I HEREBY CERTIFY THAT THIS PLAN, SPECIFICATION, PLAT, MAP, SURVEY OR REPORT WAS MADE BY ME OR UNDER MY DIRECT PERSONAL SUPERVISION AND THAT I AM A DULY REGISTERED PROFESSIONAL ENGINEER AND LAND SURVEYOR UNDER THE LAWS OF THE STATE OF IOWA

SIGNED DATE

Charles T. Vance 29 June 1987

Charles T. Vance, P.E. & L.S. Iowa Reg. No. 5041

O SET C.I.R. #5041

⊠ CUT "X" IN CONCRETE BASE OF FENCE POST

(R) RECORDED DIMENSION

(M) MEASURED DIMENSION

N

SCALE: 1"=50'

VANCE & HOCHSTETLER, P.C.
CONSULTING ENGINEERS
71 JEFFERSON STREET
WINTERSET, IOWA 50273