


PLAT OF SURVEY FOR TED WARD OF THE WEST LINE  
 OF LOT 41, HONORS ACRES SECOND ADDITION TO THE  
 CITY OF WINTERSET, MADISON COUNTY, IOWA.


FILED NO. **485**  
 BOOK 2 PAGE 32  
 TOWN PLAT  
 1987 SEP 18 AM 8:09

MARY E. WELTY  
 RECORDER  
 MADISON COUNTY, IOWA  
 Fee \$5.00

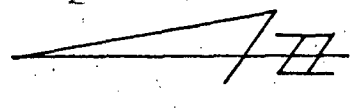

SCALE: 1" = 50'

- FOUND 3/4" IRON PIN
- FOUND 5/8" IRON PIN
- FOUND C.I.R. # 5041
- SET C.I.R. # 5041
- (P) PLATTED DIMENSION
- (M) MEASURED DIMENSION

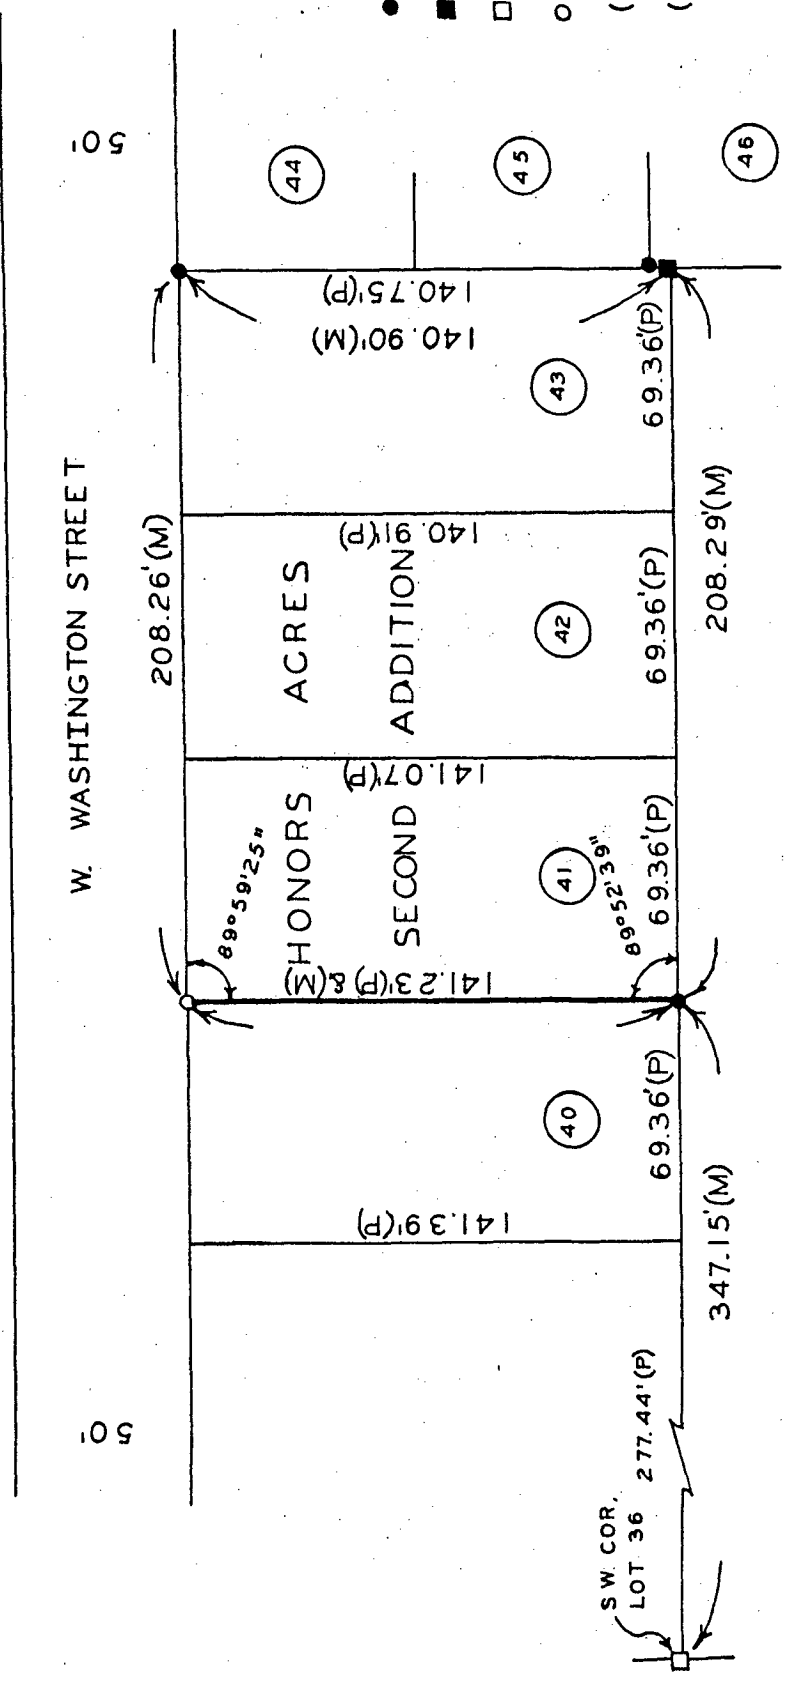

I HEREBY CERTIFY THAT THIS PLAN, SPECIFICATION, PLAT, MAP SURVEY OR REPORT WAS MADE BY ME OR UNDER MY DIRECT PERSONAL SUPERVISION AND THAT I AM A DULY REGISTERED PROFESSIONAL SURVEYOR AND LAND SURVEYOR UNDER THE LAWS OF THE STATE OF IOWA. DATE

*Charles T. Vance* 3 Sept 1987  
 Charles T. Vance, P.E. & L.S. Iowa Reg. No. 5341

VANCE & HOCHSTETLER, P.C.  
 CONSULTING ENGINEERS  
 71 JEFFERSON  
 WINTERSET, IOWA 50273