

PLAT OF SURVEY FOR JACK BENOIT
OF THE NORTH 40' OF LOTS 1 & 2 AND OF
THE NORTH 32' OF LOTS 3 & 4 IN BLOCK 4,
ORIGINAL TOWN OF WINTERSET, MADISON COUNTY, IOWA.

FILED NO. 1940

BOOK 2 PAGE 198

94 JAN 21 AM 10: 23


MICHELLE UTSLER
RECORDER
MADISON COUNTY, IOWA

REC \$ 5.00

AUD \$

R.M.F. \$ 1.00

COMPUTER
RECORDED
COMPARED

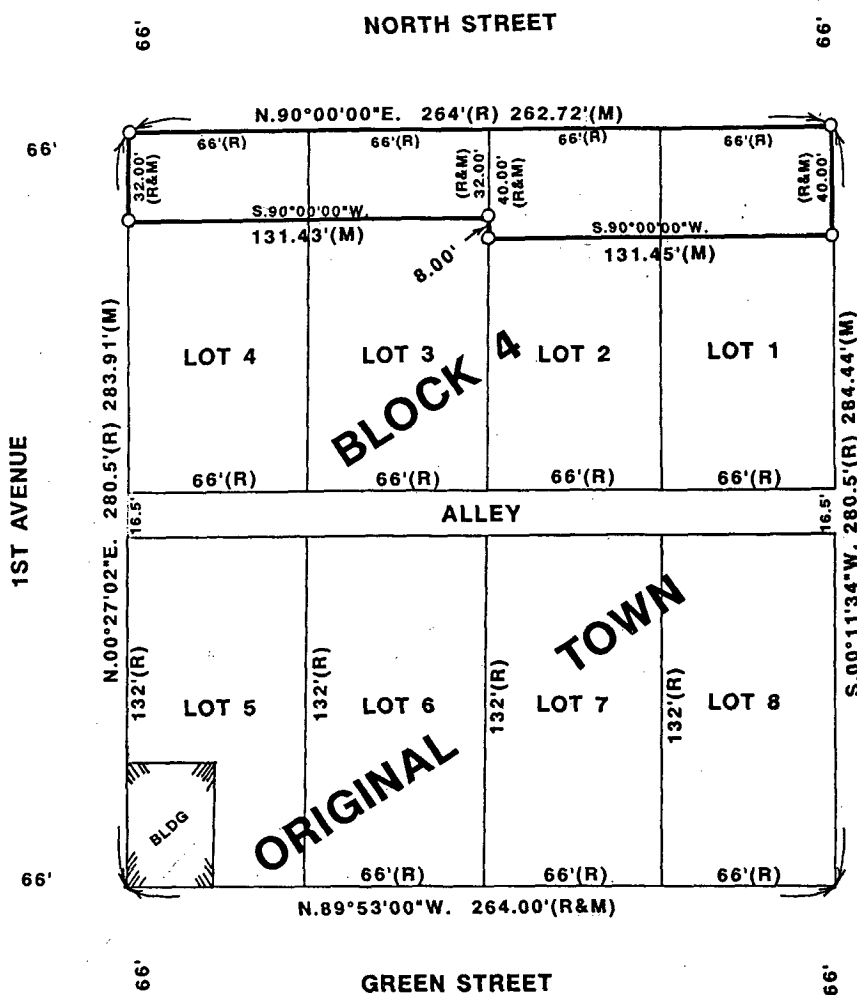

○ SET C.I.R. #6808
(R) RECORDED DIMENSION
(M) MEASURED DIMENSION



SCALE: 1" = 50'



DATE OF SURVEY:
JANUARY 5, 1994

I HEREBY CERTIFY THAT THIS PLAN, SPECIFICATION,
PLAT, MAP, SURVEY, OR REPORT WAS PREPARED BY
ME OR UNDER MY DIRECT PERSONAL SUPERVISION
AND THAT I AM A DULY REGISTERED PROFESSIONAL
ENGINEER AND LAND SURVEYOR UNDER THE LAWS
OF THE STATE OF IOWA. MY REGISTRATION

EXPIRES Dec. 31, 1995

SIGNED J.M. Hochstetler DATE 1/7/94
J.M. HOCHSTETLER IOWA REG. NO. 6808

VANCE & HOCHSTETLER, P.C.
CONSULTING ENGINEERS
71 JEFFERSON STREET
WINTERSET, IOWA 50273