

PLAT OF SURVEY FOR TOM BUSH OF LOT 8, BLOCK 2,  
DANFORTH'S ADDITION TO THE CITY OF WINTERSET,  
MADISON COUNTY, IOWA

COMPUTER   
RECORDED   
COMPARED

REC \$ 500  
AUD \$ \_\_\_\_\_  
R.M.F. \$ 100


FILED NO. 323

BOOK 2 PAGE 215

94 AUG -2 PM 1:55

**BENTON STREET**

MICHELLE UTSLER  
RECORDER  
MADISON COUNTY, IOWA

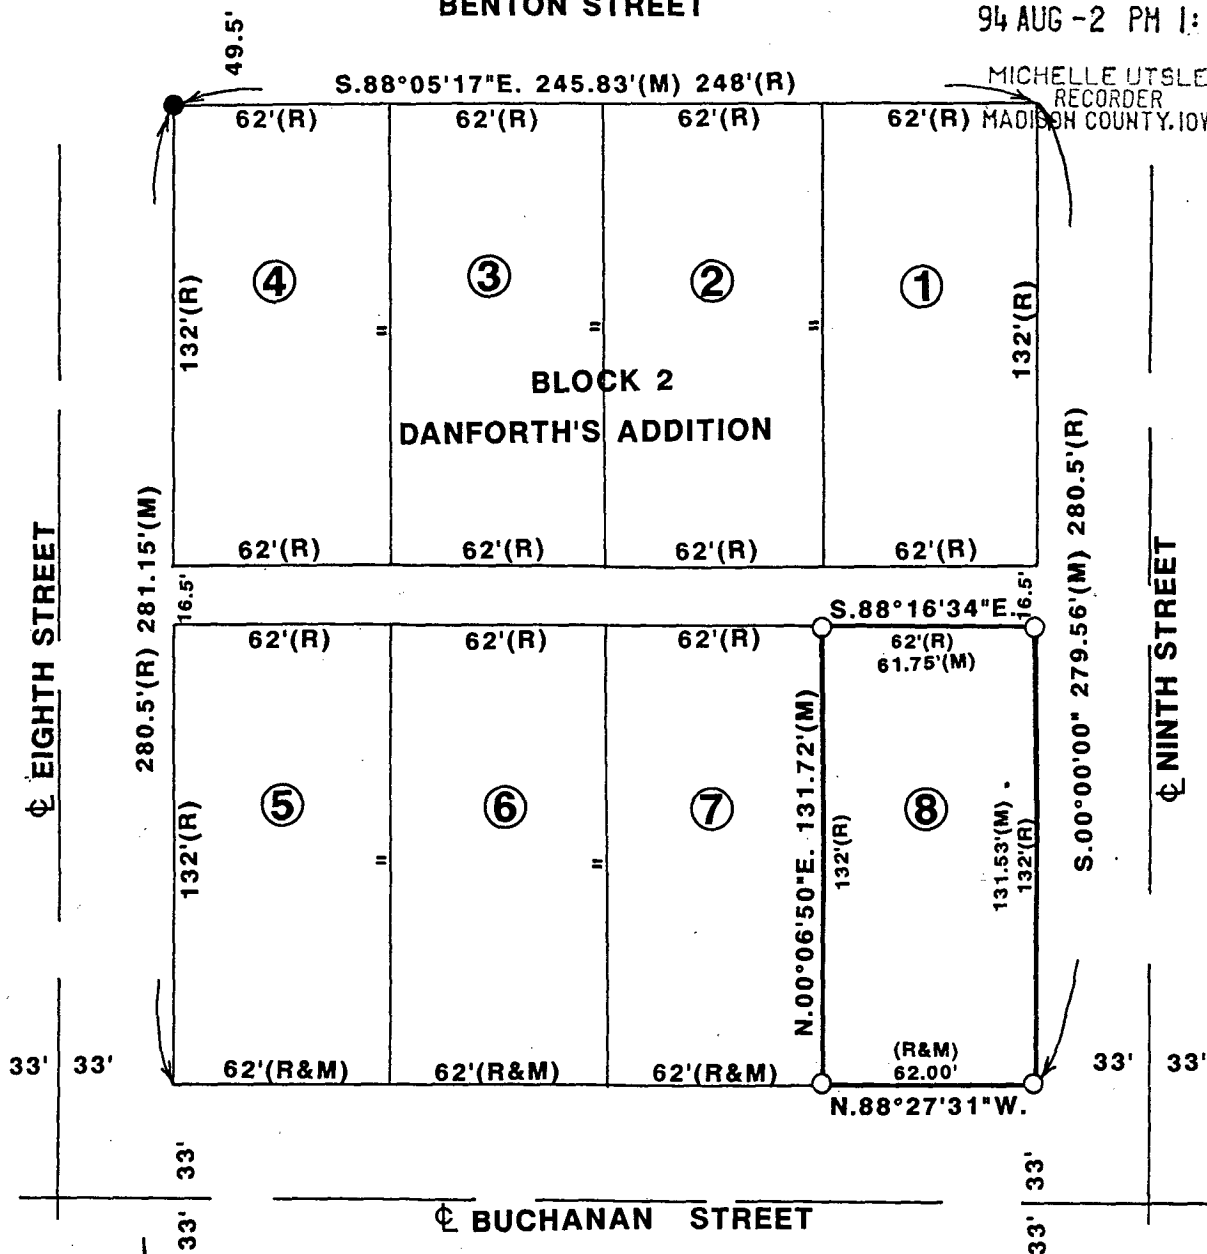

SCALE: 1" = 50'



I HEREBY CERTIFY THAT THIS PLAN, SPECIFICATION,  
PLAT, MAP, SURVEY, OR REPORT WAS PREPARED BY  
ME OR UNDER MY DIRECT PERSONAL SUPERVISION  
AND THAT I AM A DULY REGISTERED PROFESSIONAL  
ENGINEER AND LAND SURVEYOR UNDER THE LAWS  
OF THE STATE OF IOWA. MY REGISTRATION

EXPIRES Dec. 31, 1995  
SIGNED J.M. Hochstetler DATE 7/29/94  
J.M. HOCHSTETLER IOWA REG. NO. 6808

- SET C.I.R. #6808
- FOUND 5/8" IRON ROD
- (R) RECORDED DIMENSION
- (M) MEASURED DIMENSION

DATE OF SURVEY:  
JUNE 7, 1994

TOWN PLAT 2

VANCE & HOCHSTETLER, P.C.  
CONSULTING ENGINEERS  
71 JEFFERSON  
WINTERSET, IOWA 50273