

REC \$ 5.00
 AUD \$
 R.M.F. \$ 1.00


FILED NO. 1468
 BOOK 2 PAGE 305
 96 NOV 26 PM 2:29
 MICHELLE UTSLER
 RECORDER
 MADISON COUNTY, IOWA

COMPUTER
 RECORDED
 COMPARED

VANCE & HOCHSTETLER, P.C. CONSULTING ENGINEERS, WINTERSET, IOWA (515)462-3995

CHARLES T. VANCE, 110 WEST GREEN ST., WINTERSET, IOWA 50273
 JAMES M. HOCHSTETLER, 110 WEST GREEN ST., WINTERSET, IOWA 50273

PLAT OF SURVEY FOR CLAIR JONES OF LOT 8, BLOCK 5
 OF THE ORIGINAL TOWN OF EARLHAM, MADISON COUNTY, IOWA.

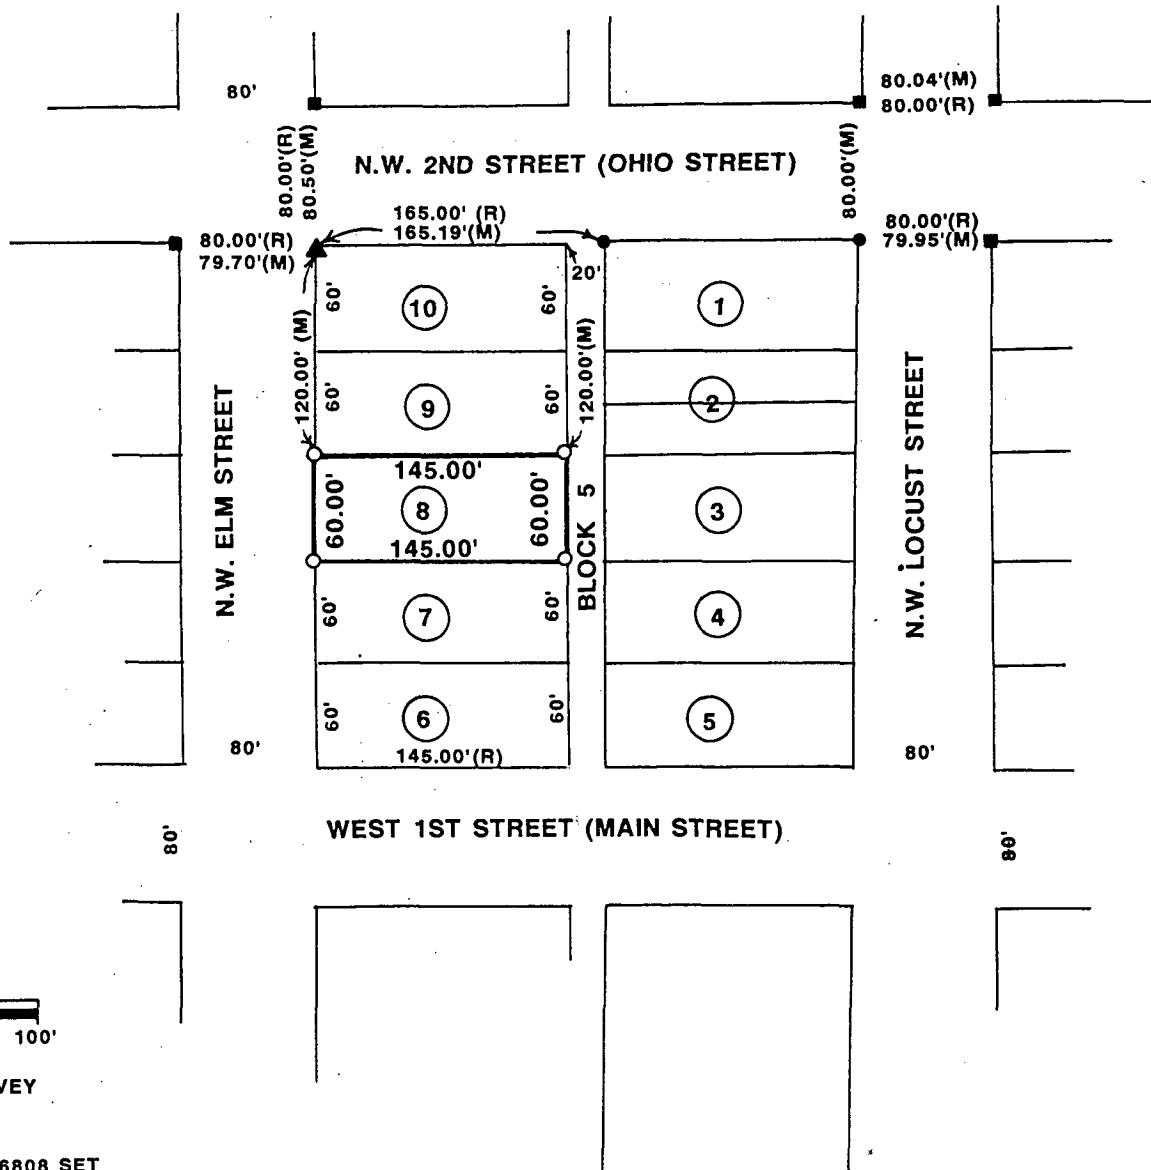

DATE OF SURVEY
 11/20/96

- C.I.R. # 6808 SET
- 1/2" IRON PINS FD.
- 1" IRON PINS FD.
- ▲ LIMESTONE ROCK FD.
- (M) MEASURED DISTANCE
- (R) RECORDED DISTANCE

LEGAL DESCRIPTION:

LOT 8 OF BLOCK 5 OF THE ORIGINAL TOWN
 OF EARLHAM, MADISON COUNTY, IOWA.

I hereby certify that this land surveying document was prepared
 by me or under my direct supervision and that I am a duly
 Registered Land Surveyor under the laws of the State of Iowa.

Signature: J.M. Hochstetler
 J.M. Hochstetler
 Date: 11/22/96 Reg. No. 6808
 (Month, day, year)

My registration renewal date is December 31, 1997

