

REC \$ 5.00
AUD \$
R.M.F. \$ 1.00
COMPUTER ✓
RECORDED ✓
COMPARED ✓



FILED NO. 4904
BOOK 2 PAGE 356
98 MAY 26 AM 8:56
MICHELLE UTSLER
RECORDER
MADISON COUNTY, IOWA

VANCE & HOCHSTETLER, P.C. CONSULTING ENGINEERS, WINTERSSET, IOWA (515)462-3995
CHARLES T. VANCE 110 WEST GREEN ST., WINTERSSET, IOWA 50273
JAMES M. HOCHSTETLER, 110 WEST GREEN ST., WINTERSSET, IOWA 50273


A PLAT OF SURVEY FOR JAMES & LISA ADAMS OF LOT 3, BLOCK 1 OF HULL'S ADDITION TO THE TOWN OF TRURO, MADISON COUNTY, IOWA.

- Fd. C.I.R. #5041
- Fd. C.I.R. #8034
- Fd. Nail in road
- Fd. "X" in sidewalk
- Set C.I.R. #6808
- (M) Measured Dimension
- (P) Platted Dimension

LEGEND

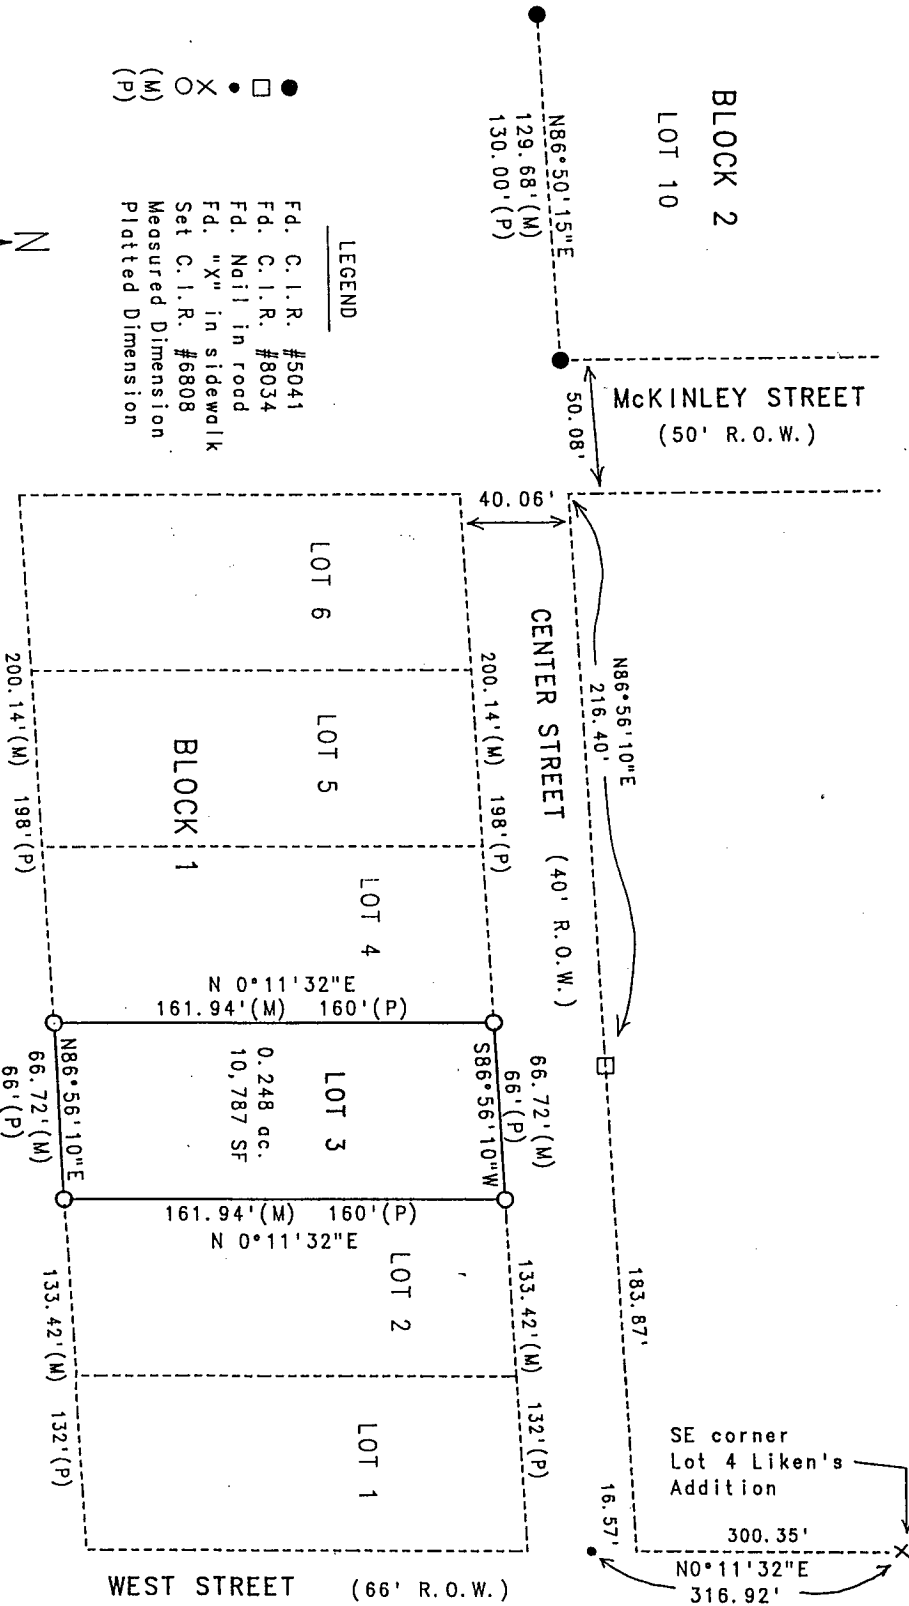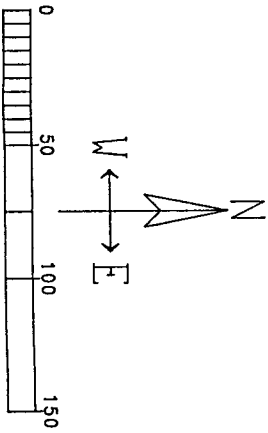

DATE OF SURVEY:
May 12, 1998
SCALE: 1" = 50'

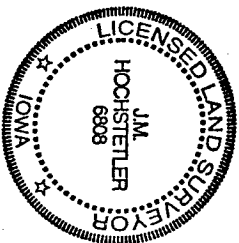

I hereby certify that this land surveying document was prepared and the related survey work was performed by me or under my direct personal supervision and that I am a duly licensed Land Surveyor under the laws of the State of Iowa.

J.M. HOCHSTETLER
License number 6808
Date 5/15/98
My license renewal date is December 31, 1999.
Pages or sheets covered by this seal: 1