

PLAT OF SURVEY

REC'D 5  
AUD \$  
P.M.F. \$

COMPUTER   
RECORDED   
COMPARED   
3564

FILED NO. \_\_\_\_\_  
BOOK 2 PAGE 391  
99 MAR -2 PH 1: 53  
MICHELLE UTSLER  
RECORDER  
MADISON COUNTY, IOWA




Legend:  
 o found corner  
 o set I.P. w/I.D. exp 3/15  
 P. Platted Dimension  
 M. Measured Dimension

Owner: Darwin B. and Karen K. Barnett

Property Description Parcel "A"



*Barry Bishop*

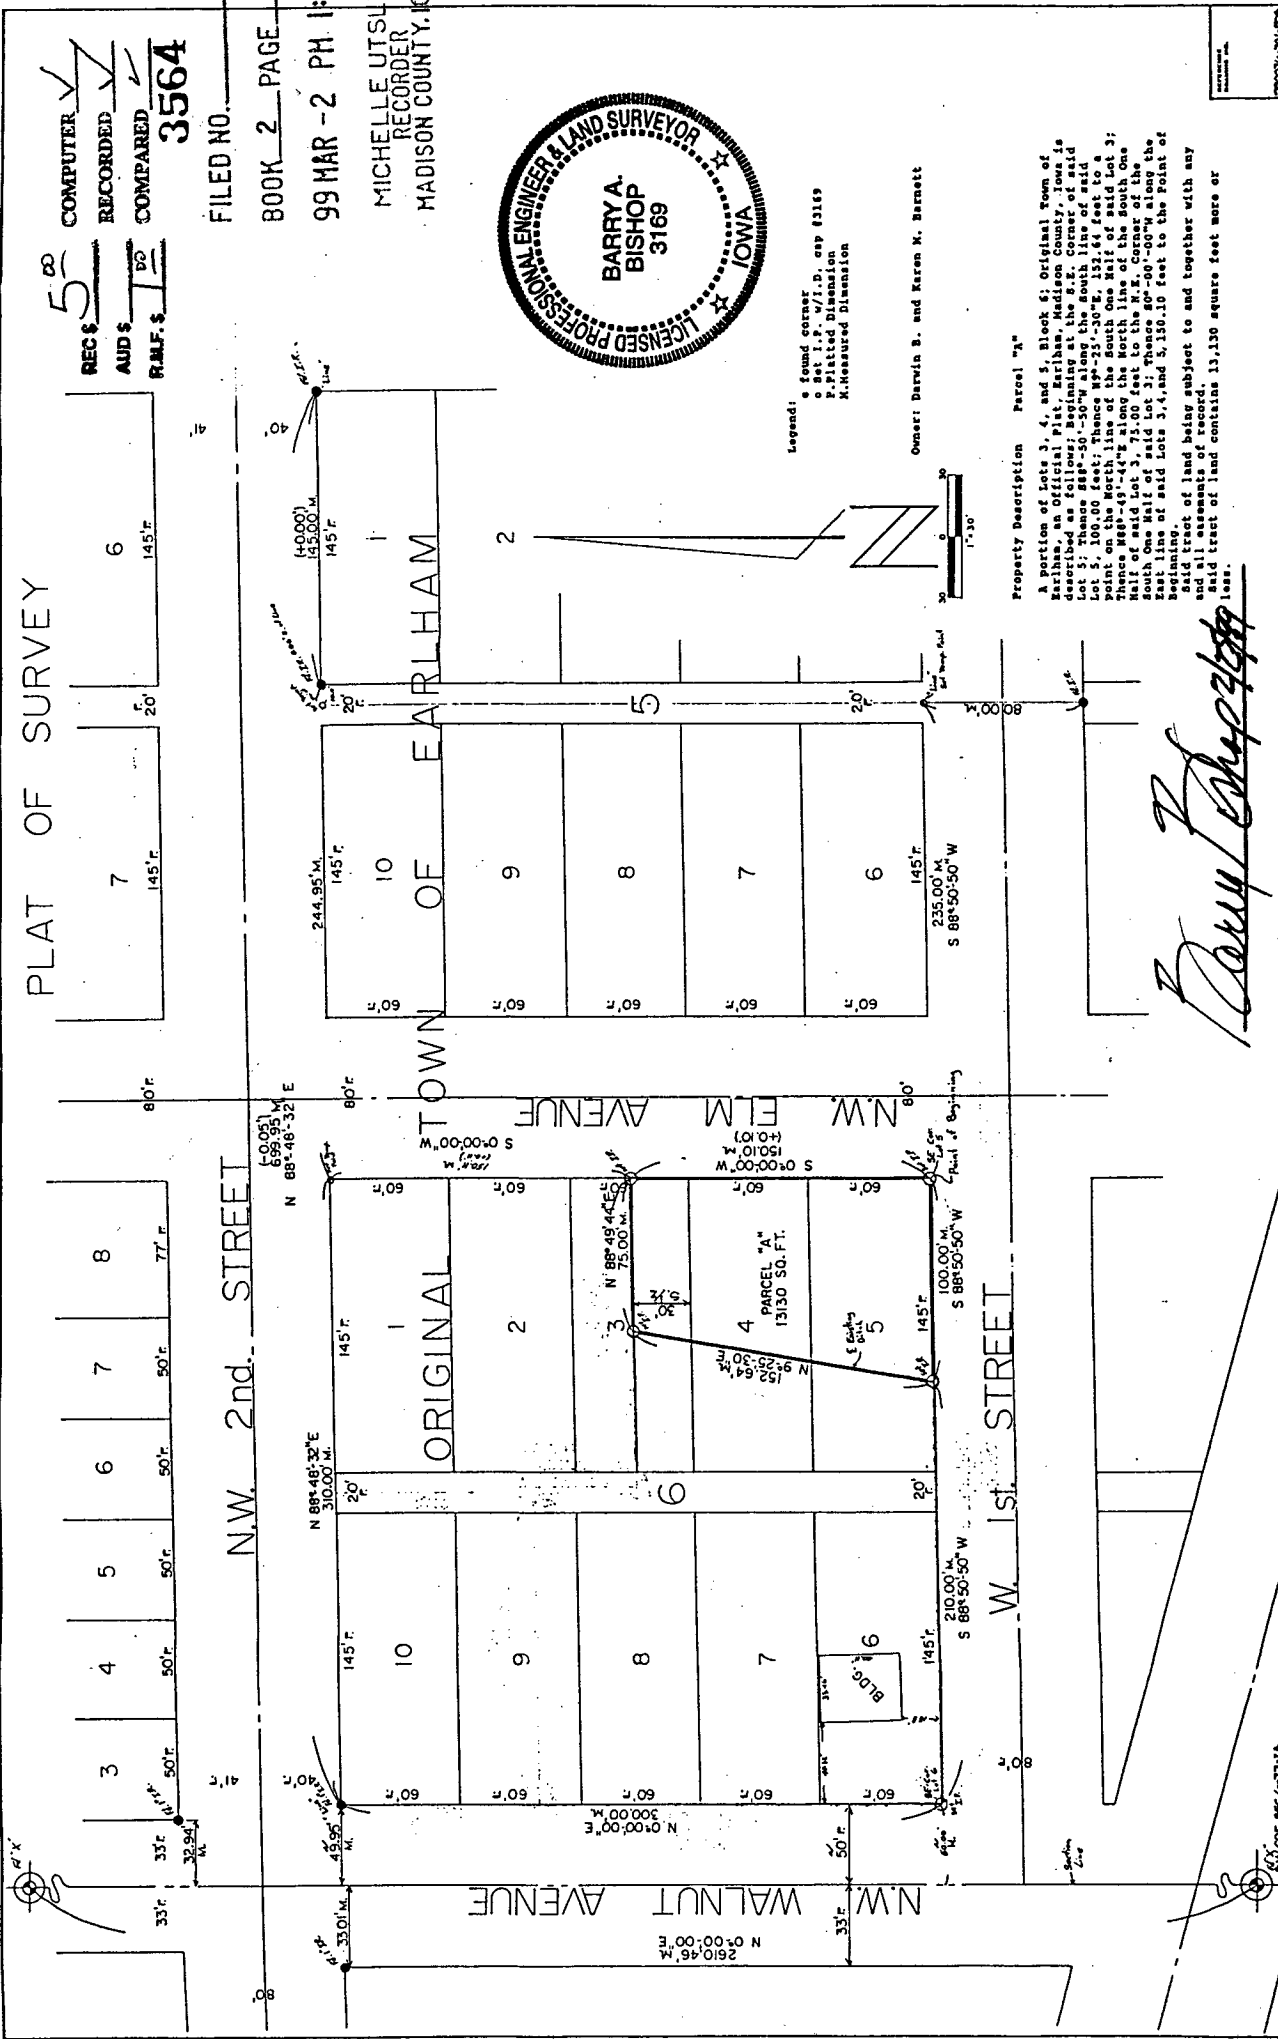

660 DEC 96-6-3712

**Bishop Engineering Company**  
3501 104th Street  
Des Moines, Iowa 50322


660 DEC 96-6-3712

17