


REC \$ 5.00
AUD \$
R.M.F. \$ 1.00

COMPUTER ✓
RECORDED ✓
COMPARED ✓

FILED NO. 2498
BOOK 2 PAGE 382
98 DEC 16 PM 3:18


VANCE & HOCHSTETLER, P.C. CONSULTING ENGINEERS, WINTERSET, IOWA (515) 462-3995
CHARLES T. VANCE 110 WEST GREEN ST., WINTERSET, IOWA 50273 MICHELLE STEEL
JAMES M. HOCHSTETLER, 110 WEST GREEN ST., WINTERSET, IOWA 50273 RECORDER
MADISON COUNTY, IOWA

PLAT OF SURVEY FOR WILLIAM K. AND DELORIS E. KIRKPATRICK OF THE EAST 50 FEET OF LOT 5, BLOCK 2, LAUGHRIDGE & CASSIDAY'S ADDITION TO THE CITY OF WINTERSET, MADISON COUNTY, IOWA.

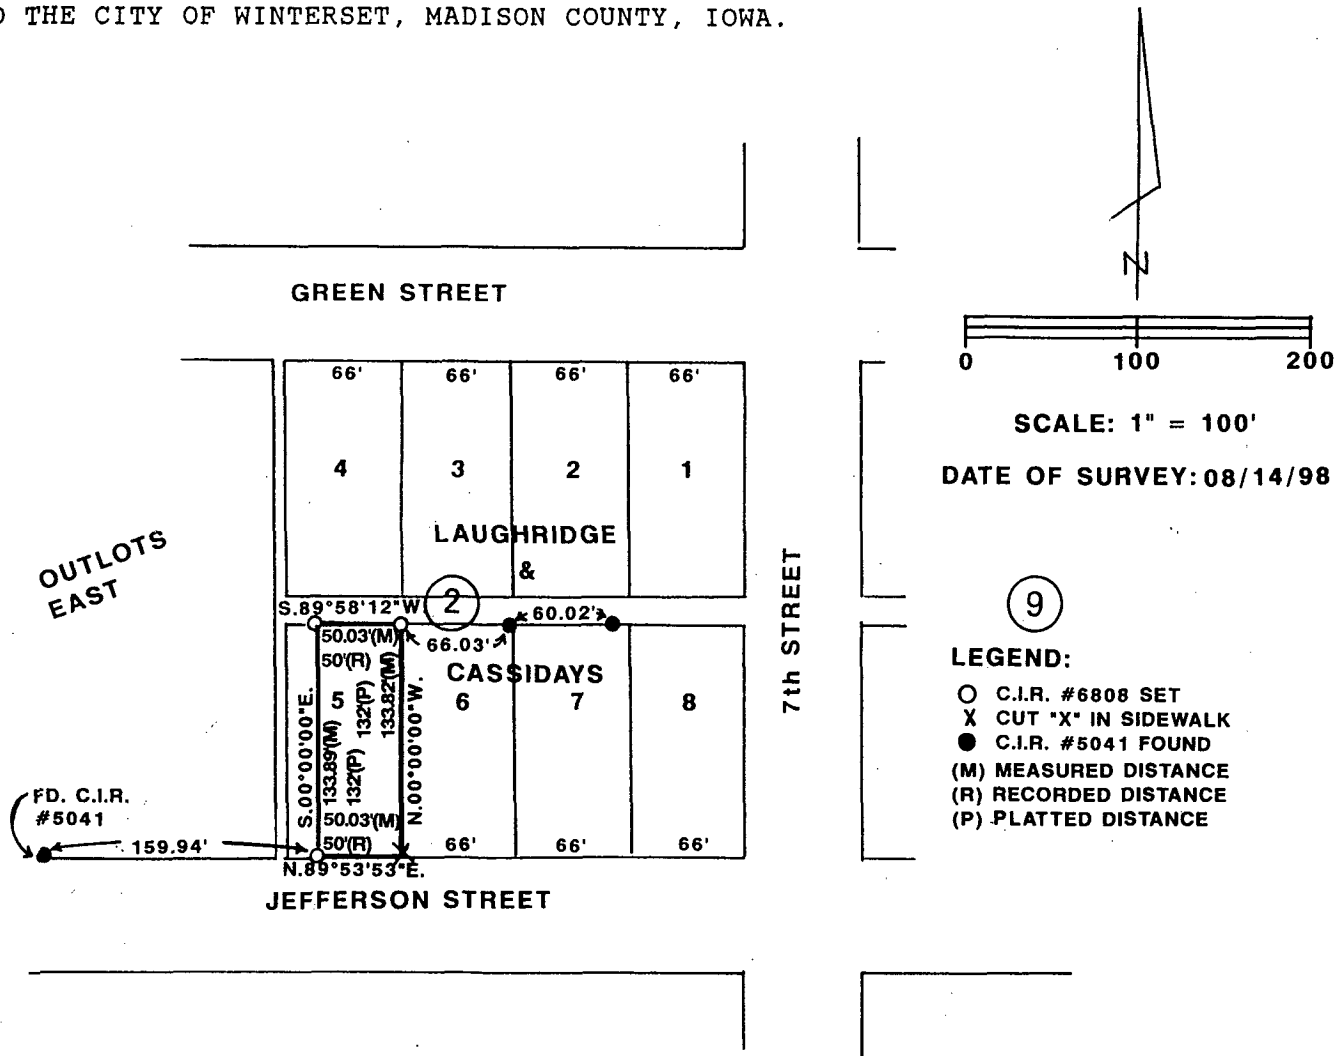

LEGAL DESCRIPTION:

THE EAST 50 FEET OF LOT 5, BLOCK 2, LAUGHRIDGE & CASSIDAY'S ADDITION TO THE CITY OF WINTERSET, MADISON COUNTY, IOWA.

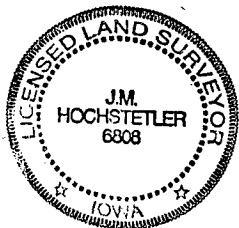

I hereby certify that this land surveying document was prepared and the related survey work was performed by me or under my direct personal supervision and that I am a duly licensed Land Surveyor under the laws of the State of Iowa.

J.M. Hochstetler
 J.M. HOCHSTETLER
 License number 6808
 Date 12/11/98
 My license renewal date is December 31, 1999.
 Pages or sheets covered by this seal: 1