


REC \$ 5.00  
AUD \$  
R.M.F. \$ 1.00  
COMPUTER ✓  
RECORDED ✓  
COMPARED ✓


FILED NO. 001149 416  
BOOK 2 PAGE 416  
99 SEP 15 PH 3:45  
MICHELLE OTSLER  
RECORDER  
MADISON COUNTY, IOWA

VANCE & HOCHSTETLER, P.C. CONSULTING ENGINEERS, WINTERSET, IOWA (515) 462-3995  
CHARLES T. VANCE, 110 WEST GREEN ST., WINTERSET, IOWA 50273  
JAMES M HOCHSTETLER, 110 WEST GREEN ST., WINTERSET, IOWA 50273

PLAT OF SURVEY OF A PORTION OF LOT 54 OF THE ORIGINAL TOWN OF MACKSBURG,  
MADISON COUNTY, IOWA FOR SHIRLEY AND LEONARD W. BAILEY.

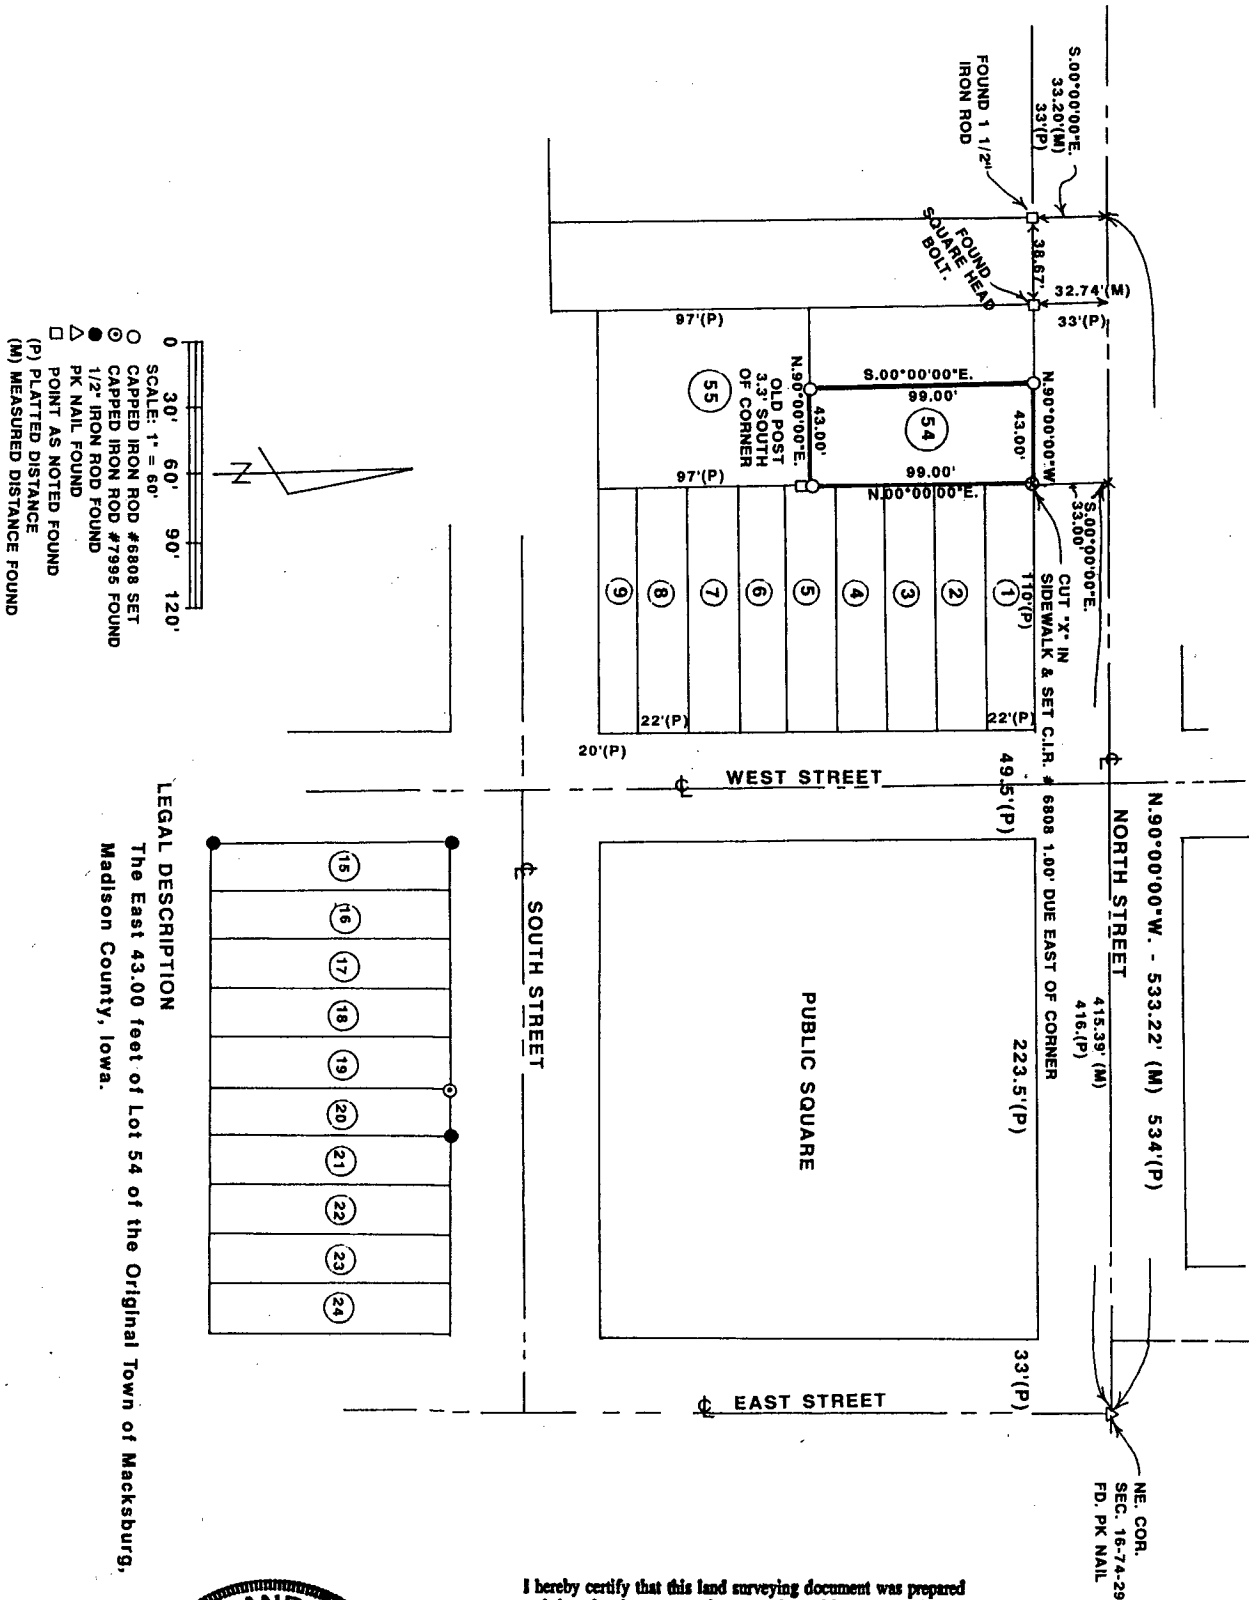

LEGAL DESCRIPTION  
The East 43.00 feet of Lot 54 of the Original Town of Macksburg,  
Madison County, Iowa.

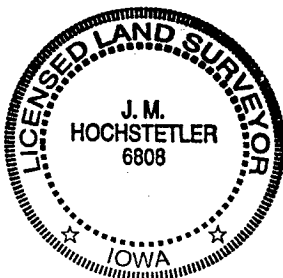

I hereby certify that this land surveying document was prepared and the related survey work was performed by me or under my direct personal supervision and that I am a duly licensed Land Surveyor under the laws of the State of Iowa.

*J.M. Hochstetler*  
J. M. HOCHSTETLER

License number 6808 Date 9/2/99

My license renewal date is December 31, 1999.

Pages or sheets covered by this seal: 1