

REC \$ 5.00
AUD \$
R.M.F. \$

FILED NO. 002362

BOOK 2 PAGE 428


1999 DEC 22 PM 2:47

CORRECTED ✓
RECORDED ✓
INDEXED ✓

CHARLETTA UTSLER
RECORDER
MADISON COUNTY, IOWA


VANCE & HOCHSTETLER, P.C. CONSULTING ENGINEERS, WINTERSET, IOWA (515) 462-3995
CHARLES T. VANCE, 110 WEST GREEN ST., WINTERSET, IOWA 50273
JAMES M HOCHSTETLER, 110 WEST GREEN ST., WINTERSET, IOWA 50273

PLAT OF SURVEY OF LOT 9 AND SOUTH HALF OF LOT 10, BLOCK 4, B.F. ALLEN'S ADDITION TO THE TOWN OF EARLHAM, MADISON COUNTY, IOWA FOR BOARD OF TRUSTEES, PRESBYTERIAN CHURCH, EARLHAM, IOWA.

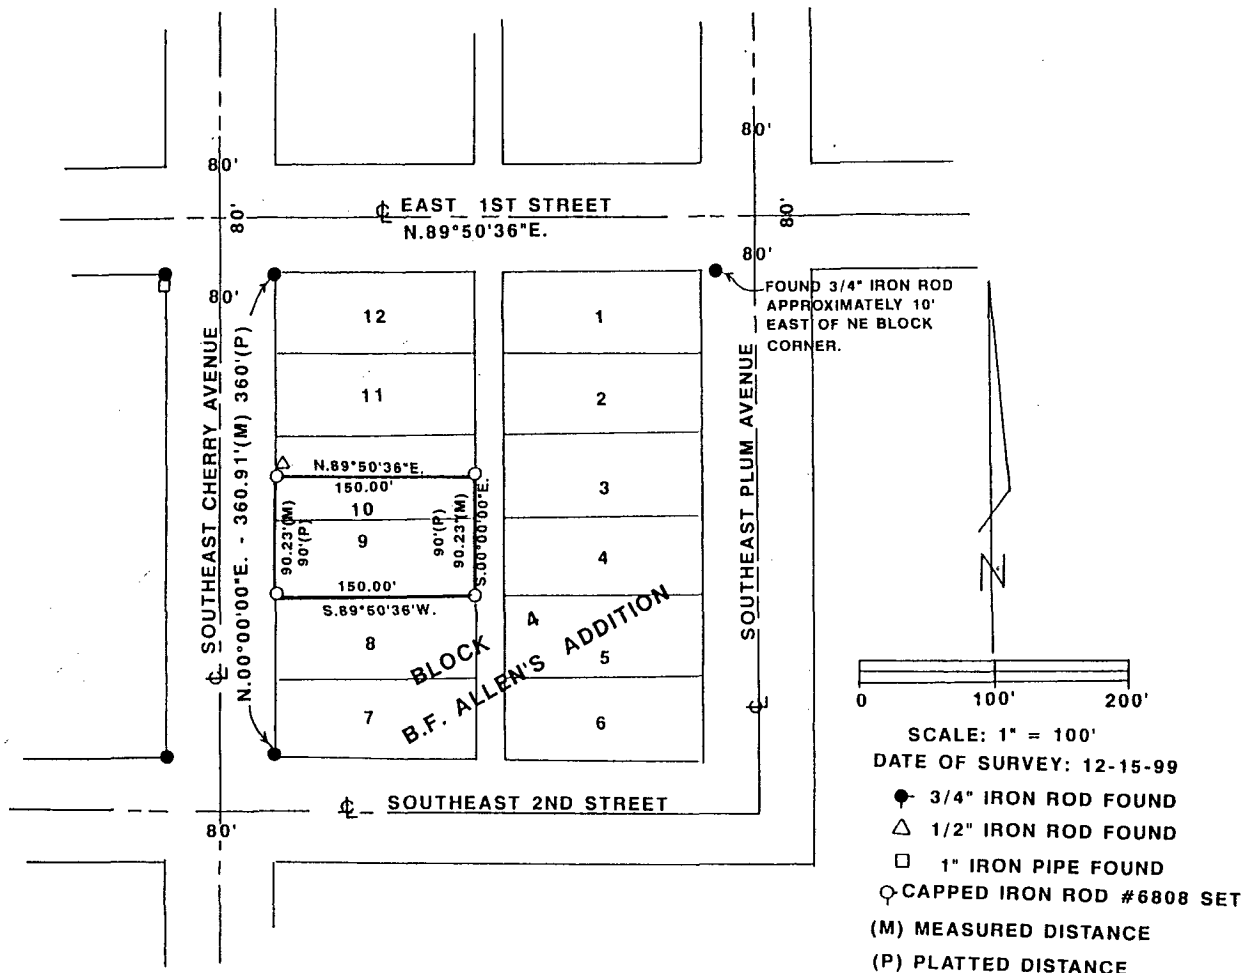

LEGAL DESCRIPTION:

LOT 9 AND THE SOUTH HALF OF LOT 10, BLOCK 4, B.F. ALLEN'S ADDITION TO THE TOWN OF EARLHAM, MADISON COUNTY, IOWA.

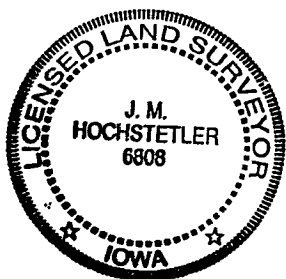

I hereby certify that this land surveying document was prepared and the related survey work was performed by me or under my direct personal supervision and that I am a duly licensed Land Surveyor under the laws of the State of Iowa.

J.M. Hochstetler
J.M. HOCHSTETLER

License number 6808 Date 12/22/99

My license renewal date is December 31, 1999.

Pages or sheets covered by this seal: 1