



VANCE & HOCHSTETLER, P.C., CONSULTING ENGINEERS, WINTERSET, IOWA (515) 462-3995
CHARLES T. VANCE, 110 WEST GREEN ST., WINTERSET, IOWA 50273
JAMES M HOCHSTETLER, 110 WEST GREEN ST., WINTERSET, IOWA 50273


FILED NO. **005022**

BOOK 2 PAGE 452

2000 JUL 10 PM 2:27


MICHELLE UTSLER
RECORDER
MADISON COUNTY, IOWA

- CAPED IRON ROD (CIR) #6808 SET
- 1" GAS PIPE FOUND
- ☐ CIR #6808 FOUND
- ✗ CALCULATED POINT NOTHING SET
- (M) MEASURED DISTANCE
- (P) PLATTED DISTANCE

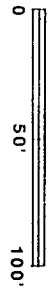


NORTHWEST STREET

FOUND
CIR #6808

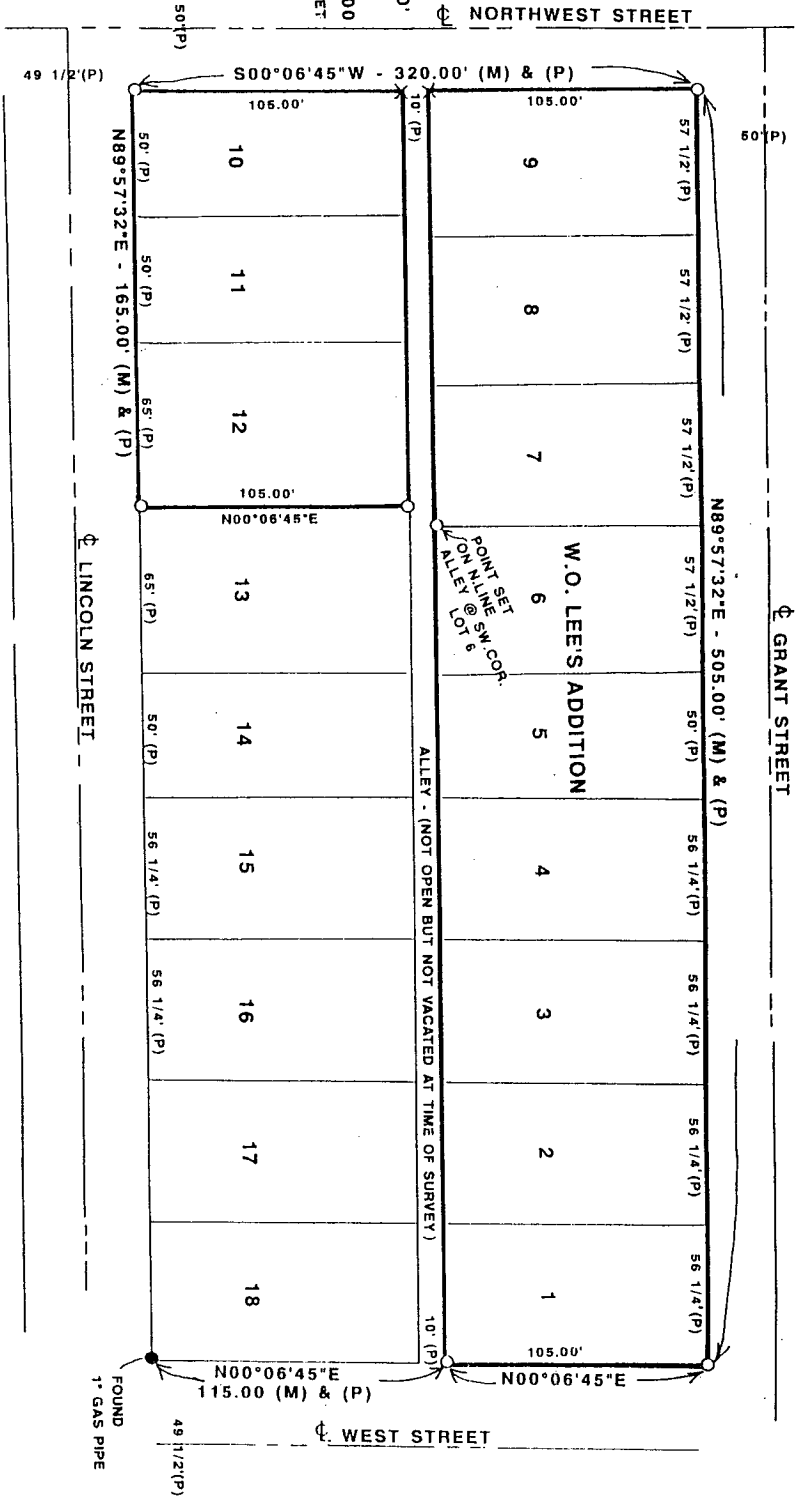

PLAT OF SURVEY FOR LINDA DOLSON BACKUS OF LOTS 1 THROUGH 12 IN BLOCK 3 OF
W.O. LEE'S ADDITION TO THE TOWN OF MACKSBURG, MADISON COUNTY, IOWA

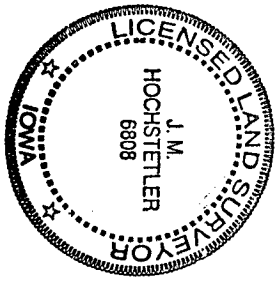

I hereby certify that this land surveying document was prepared and the related survey work was performed by me or under my direct personal supervision and that I am a duly Licensed Land Surveyor under the laws of the State of Iowa.

J.M. Hochstetler
J.M. HOCHSTETLER
License number 6808 Date 7/5/2000

My license renewal date is December 31, 2001
Pages or sheets covered by this plat: 1