



INDX  
ANNO  
SCAN  
CHEK




LISA SMITH, COUNTY RECORDER  
MADISON COUNTY IOWA

DANIELS LAND SURVEYING, 22598 18TH AVE, NEW VIRGINIA, IA 50210 515-577-2583

# RETRACEMENT SURVEY

## LOT 1, BLOCK 2, KALE'S ADDITION


### CITY OF TRURO, MADISON COUNTY, IOWA

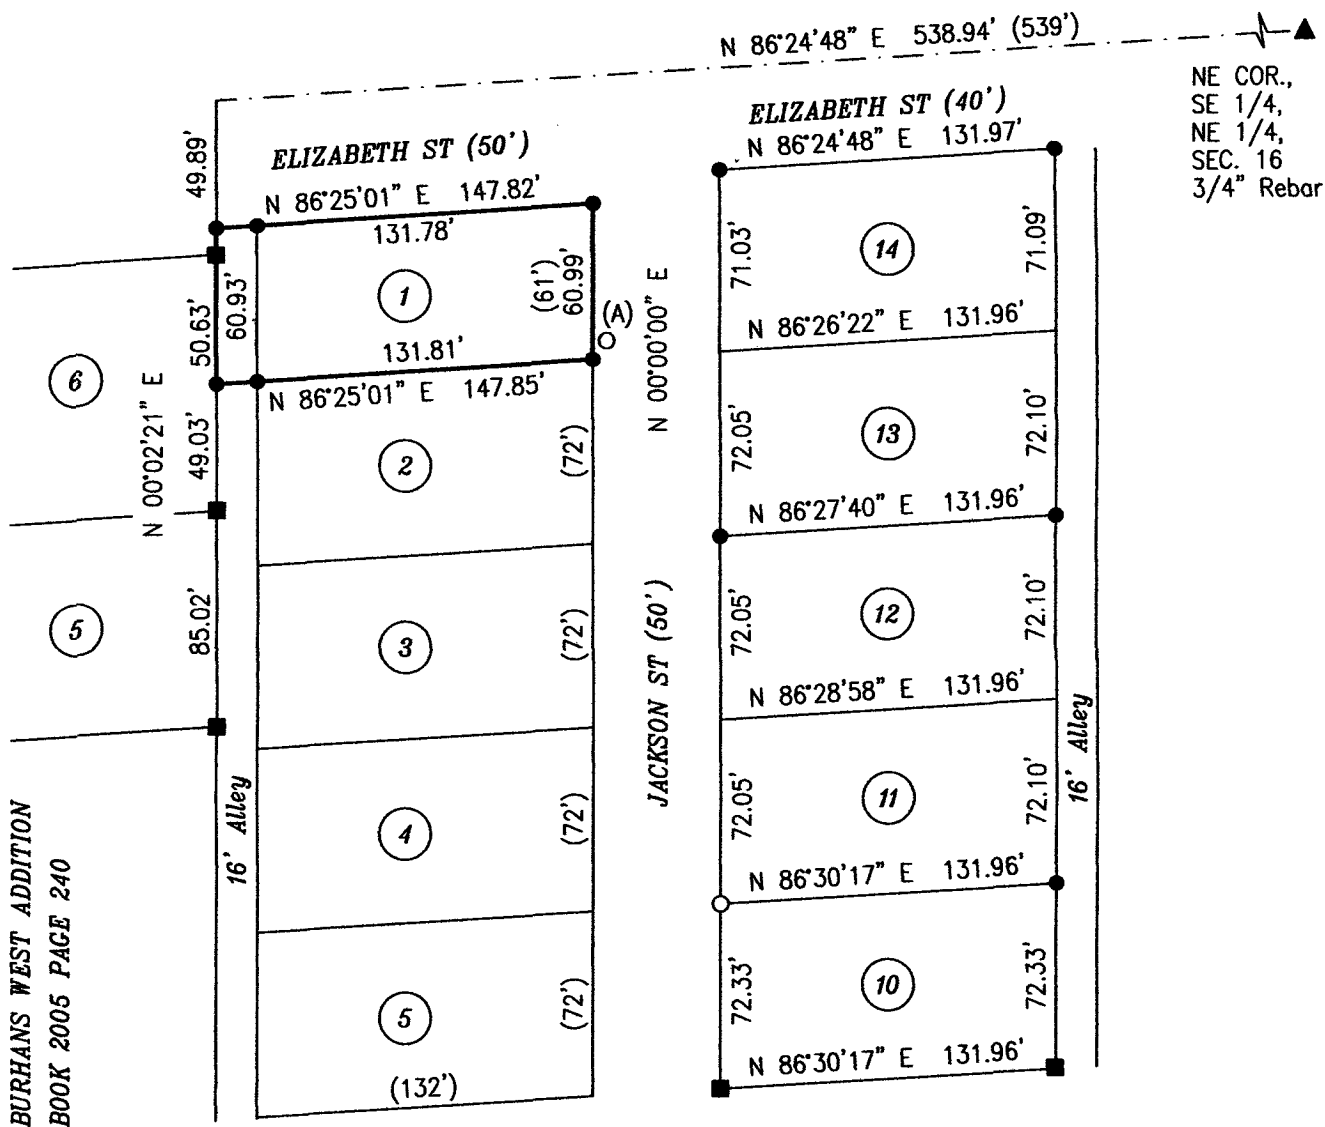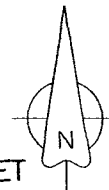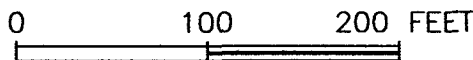

NE COR.,  
SE 1/4,  
NE 1/4,  
SEC. 16  
3/4" Rebar

(A) - Found 1/2" yellow plastic capped rebar, #5041 1.13' East and 2.47' North of corner.

- ( ) - Recorded Distance/Bearing
- Section line
- Monuments**
- ▲ - Found section corner
- - Set 1/2" red plastic capped rebar, #17532
- - Found 5/8" orange plastic capped rebar, #7995
- - Found 1" Gas Pipe (unless noted)

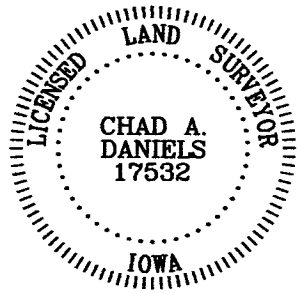

I hereby certify that this surveying document was prepared by me and the related survey work was performed by me or under my direct personal supervision and that I am a duly licensed Land Surveyor under the laws of the State of Iowa.

Signed *Chad A. Daniels* 5/15/2011  
Chad A. Daniels Date

Iowa License No. 17532  
My license renewal date is 12-31-2012  
Page No.'s covered by this seal: 1