






INDX
ANNO
SCAN
CHEK

LISA SMITH, COUNTY RECORDER
MADISON COUNTY IOWA

DANIELS LAND SURVEYING, 22598 18TH AVE, NEW VIRGINIA, IA 50210 515-577-2583


RETRACEMENT SURVEY

LOTS 13 & 14, BLOCK 1, KALE'S ADDITION CITY OF TRURO, MADISON COUNTY, IOWA

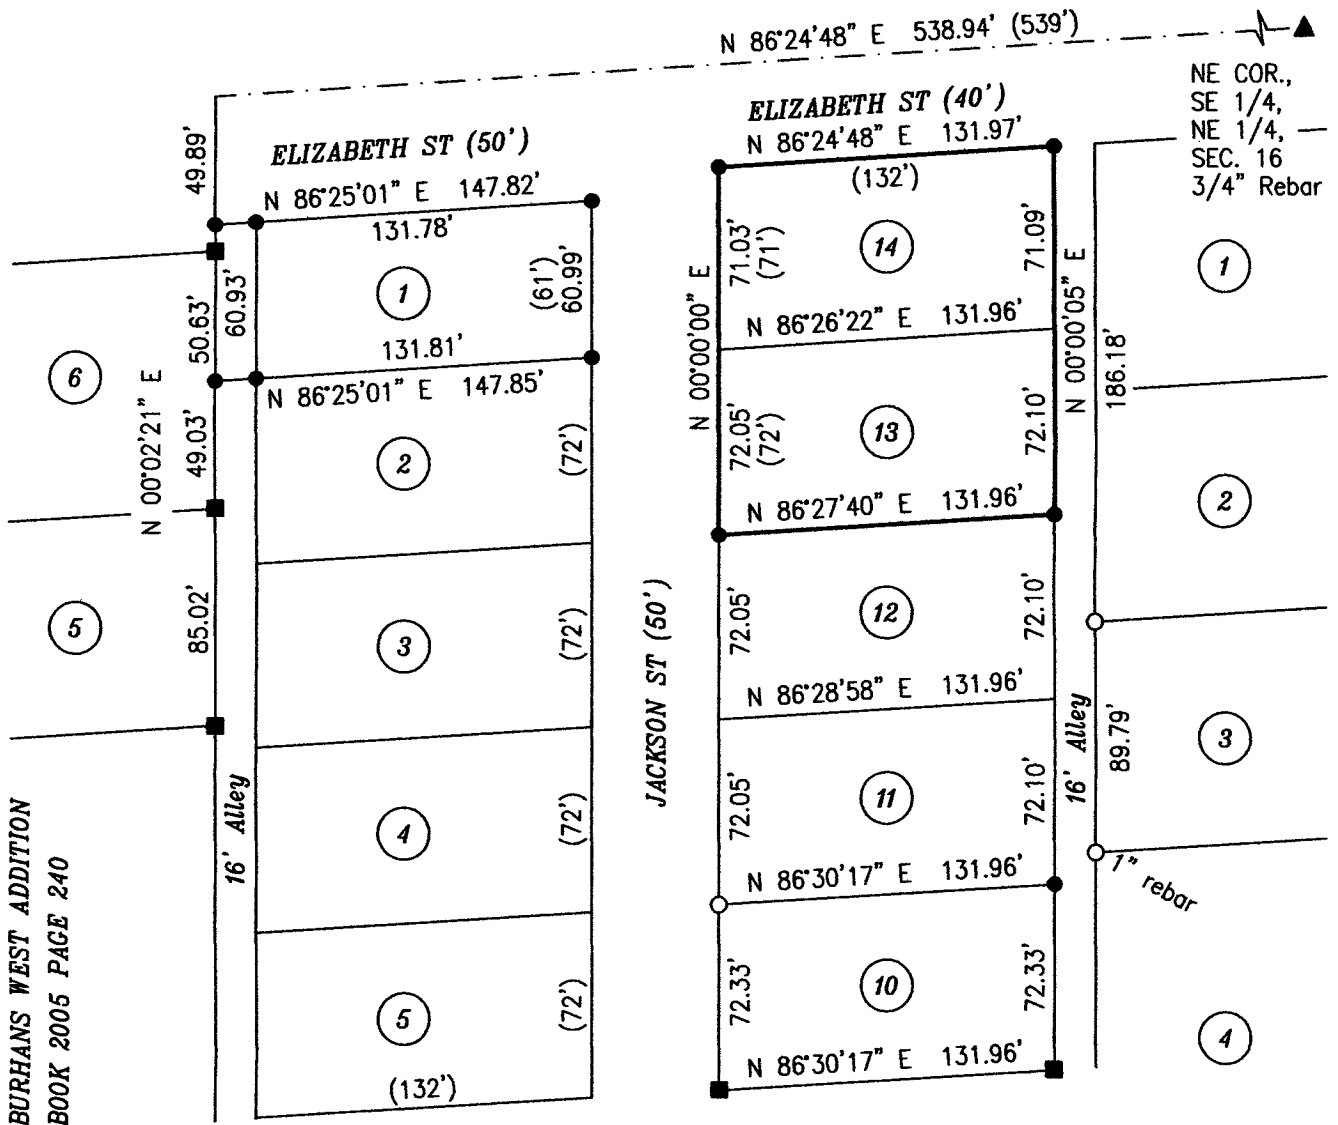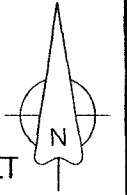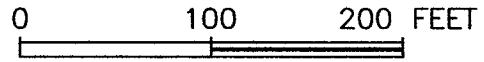

BURHANS WEST ADDITION
BOOK 2005 PAGE 240

- () - Recorded Distance/Bearing
- Section line
- Monuments**
- ▲ - Found section corner
- - Set 1/2" red plastic capped rebar, #17532
- - Found 5/8" orange plastic capped rebar, #7995
- - Found 1" Gas Pipe (unless noted)

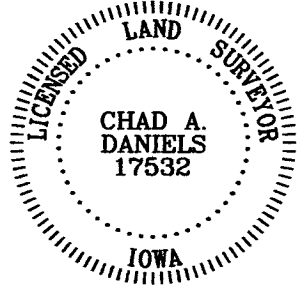

I hereby certify that this surveying document was prepared by me and the related survey work was performed by me or under my direct personal supervision and that I am a duly licensed Land Surveyor under the laws of the State of Iowa.

Signed *Chad A. Daniels* 5/15/2011
Chad A. Daniels Date

Iowa License No. 17532
My license renewal date is 12-31-2012
Page No.'s covered by this seal: 1