Document 2011 1334

Book 2011 Page 1334 Type 06 043 Pages 1
Date 5/24/2011 Time 10:59 AM
Rec Amt $9.00

INDX✓
ANNO
SCAN

LISA SMITH, COUNTY RECORDER
MADISON COUNTY IOWA

CHEK

Prepared By: J. Brian Morrissey, Morrissey Surveying, 1405 Hwy. G28, Otley, Ia. 50214, Tel. (641) 627-5554

UNITED STATES PUBLIC LAND SURVEY CORNER CERTIFICATE OF

Land Survey Monuments situated in Section 24, Township 76N, Range 26W, of the Fifth Principal Meridian, Madison County, Iowa.
Previously recorded in N.A. in County Recorders Office.


(book, page, document number,etc.)

(Show reason for preparing this certificate, the evidence and detailed procedures used in establishing the corner positions and monumentation found or placed.)

Monument Description and Remarks: Set 5/8" x 18 " orange plastic capped rebar, #7995 as witness to corner 0.09 ft. S. and 1.06 ft. E. of fence intersection and large hedge tree. Position accepted due to traversing the the S. 1/2 of Section and using a fence corner at the N. 1/4 corner. An 1875 land survey indicated a stone at the Center of Section believed to now be under the large hedge tree at corner position.

PLAN VIEW

(Show a minimum of three reference ties to durable physical objects, relevant monuments and physical conditions that will enable recovery of the corner.)

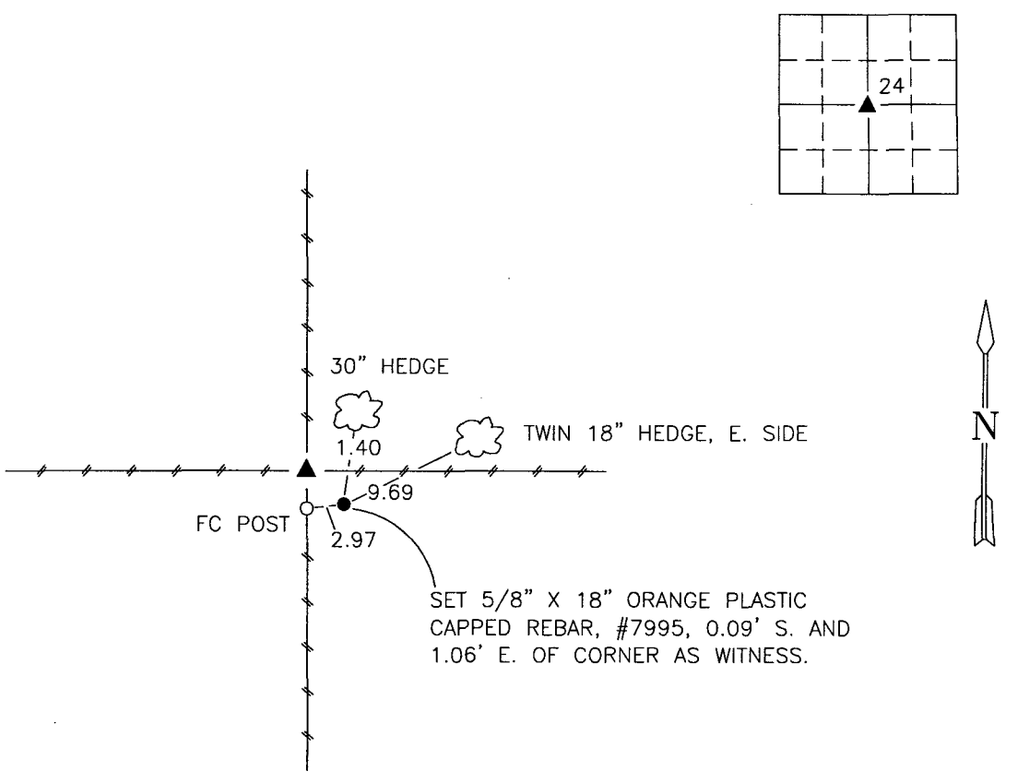

NW COR., SE 1/4, SEC. 24

NOTE: ALL TIES TO BRASS DISK NUMBER 7995 UNLESS NOTED.

LICENSED PROFESSIONAL ENGINEER & LAND SURVEYOR
J.BRIAN MORRISSEY 7995
IOWA

I hereby certify that this land surveying document was prepared and the related survey work was performed by me or under my direct personal supervision and that I am a duly Licensed Land Surveyor under the laws of the state of Iowa.

Signature: J. Brian Morrissey Date: 5/23/11
J. Brian Morrissey

License number 7995.
My license renewal date is December 31, 2011

628-10-5