Document 2011 1621

Book 2011 Page 1621 Type 06 043 Pages 1
Date 6/20/2011 Time 1:57 PM
Rec Amt $9.00

INDX ✓
ANNO
SCAN
CHEK

LISA SMITH, COUNTY RECORDER
MADISON COUNTY IOWA

VANCE & HOCHSTETLER, P.C. CONSULTING ENGINEERS, WINTERSET, IOWA (515)462-3995
CHARLES T. VANCE, 110 WEST GREEN ST., WINTERSET, IOWA 50273
JAMES M. HOCHSTETLER, 110 WEST GREEN ST., WINTERSET, IOWA 50273

UNITED STATES PUBLIC LAND SURVEY CORNER CERTIFICATE

OF


Land Survey Monuments situated in Section 35, Township 76 North, Range 27 West, of the Fifth Principal Meridian, Madison County, Iowa.
Previously recorded in Corner Certificate Book in County Recorder's Office.
(book, page, document number, etc.)

(Show reason for preparing this certificate, the evidence and detailed procedures used in establishing the corner positions and monumentation found or placed.)


Monument Description and Remarks: SE. Cor. of Sec. 35 Square Head Bolt was destroyed by installation of 12"dia C.M.P. Culv. — S.W. Cor. SE.¼ SE.¼ of Sec 35 Found C.I.R. #12971 (No Certificate Recorded) — E.¼ Cor. Sec. 35 Found C.I.R. #7844 (No Certificate Recorded)

PLAN - VIEW


(Show a minimum of three reference ties to durable physical objects, relevant monuments and physical conditions that will enable recovery of the corner.)

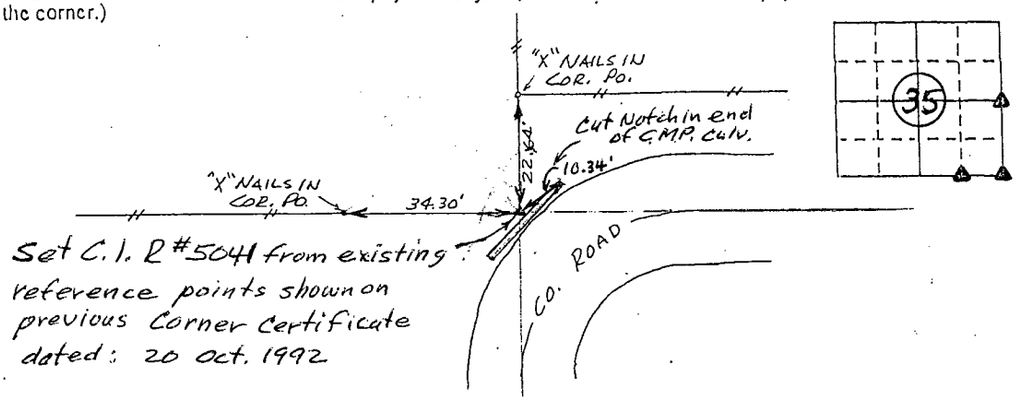

Ref. to SE. Cor., SECTION 35, T76N, R27W.

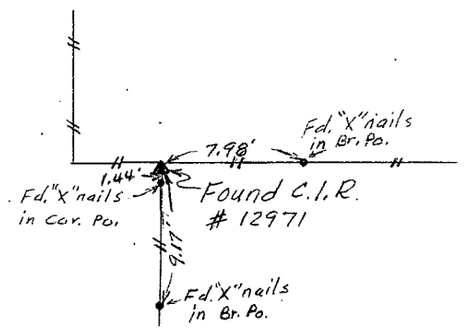

Ref. to SW. Cor. SE.¼ - SE.¼ Section 35, T76N, R27W

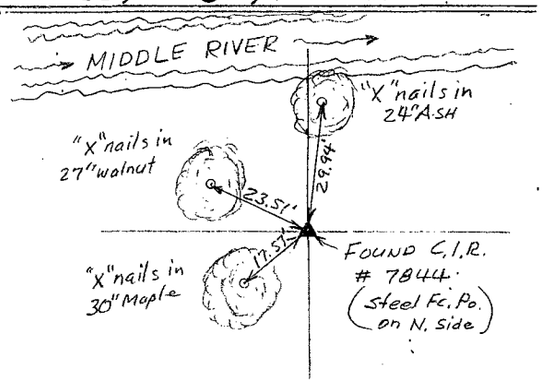

Ref. to E.¼ Cor., Section 35, T76N, R27W.

PROFESSIONAL ENGINEER LICENSED CHARLES T. VANCE 5041 IOWA LAND SURVEYOR

I hereby certify that this land surveying document was prepared and the related survey work was preformed by me or under my direct personal supervision and that I am a duly Licensed Land Surveyor under the laws of the State of Iowa.

Charles T. Vance 15 June 2011
Charles T. Vance, PE & PLS Date

License No. 5041

My License renewal date is 31, December 2011

List Corners to be Indexed

Corners	Section	Twp	Range
SE. Cor.	35	76	27
SW. Cor. SE.¼ - SE.¼	35	76	27
E.¼ Cor.	35	76	27

2011-725