Document 2011 1665

Book 2011 Page 1665 Type 06 043 Pages 1
Date 6/24/2011 Time 10:16 AM
Rec Amt $9.00

INDX ✓
ANNO
SCAN

LISA SMITH, COUNTY RECORDER
MADISON COUNTY IOWA

CHEK

VANCE & HOCHSTETLER, P.C., CONSULTING ENGINEERS, WINTERSET, IOWA (515) 462-3995
CHARLES T. VANCE, 110 West Green St., Winterset, Iowa, 50273
JAMES M HOCHSTETLER, 110 West Green St., Winterset, Iowa 50273

11-805

# UNITED STATES PUBLIC LAND SURVEY CORNER CERTIFICATE


OF

Land Survey Monuments situated in Section 9, Township 75 N, Range 28 W, of the Fifth Principal Meridian, MADISON County, Iowa.
Previously recorded in _____ In County Recorder's Office.
(book, page, document number, etc.)

(Show reason for preparing this certificate, the evidence and detailed procedures used in establishing the the corner positions and monumentation found or placed.)
Monument Description and Remarks: NW COR SE¼ NE¼ - Set yellow CIR #6808 at midpoint on line between found NW COR. SW¼ NE¼ and NE. COR. SE¼ NE¼

## PLAN - VIEW

(Show a minimum of three reference ties to durable physical objects, relevant monuments and physical conditions that will enable recovery of the corner.)

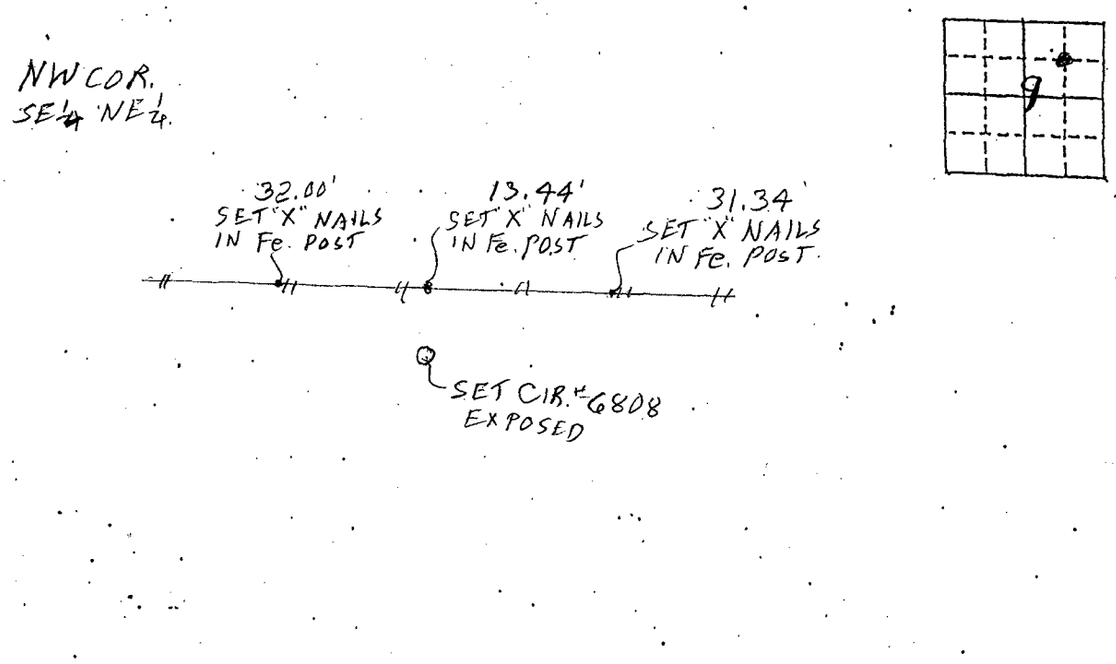


LICENSED LAND SURVEYOR
J. M. HOCHSTETLER #6808
IOWA

I hereby certify that this land surveying document was prepared and the related survey work was performed by me or under my direct personal supervision and that I am a duly licensed Land Surveyor under the laws of the State of Iowa.

J.M. Hochstetler

J.M. HOCHSTETLER
License number 6808 Date 6/22/11
My license renewal date is December 31, 2011
Pages or sheets covered by this seal: 1

List Corners to be Indexed

| Corners | Section | Twp. | Ran. |
|---|---|---|---|
| NW COR SE¼ NE¼ | 9 | 75N | 28W |