



Document 2011 1780

Book 2011 Page 1780 Type 06 043 Pages 1

Date 7/07/2011 Time 10:49 AM

Rec Amt \$7.00

INDX
ANNO
SCAN

LISA SMITH, COUNTY RECORDER
MADISON COUNTY IOWA

CHEK

Prepared by and Return to: Boldman Surveying Consultants LLC 521 West Green St. Winterset, IA 50273 Phone (515)462-9242 Cell (515) 971-9242


UNITED STATES PUBLIC LAND SURVEY CORNER CERTIFICATE

Land Survey Monuments situated in Section 13, Township 74, Range 29, the Fifth Principal Meridian, Madison County, Iowa.
Previously recorded in NONE FOUND in County Recorder's Office

Monument Description and Remarks: SE cor- researched county surveyor books found nothing. There was no evidence of occupation fences on either side of road except for a double gate on the North side. Used single proportion along the Township line between found SE cor of sec 24 and found NE corner of sec 13 to est corner

PLAN-VIEW

SE Corner

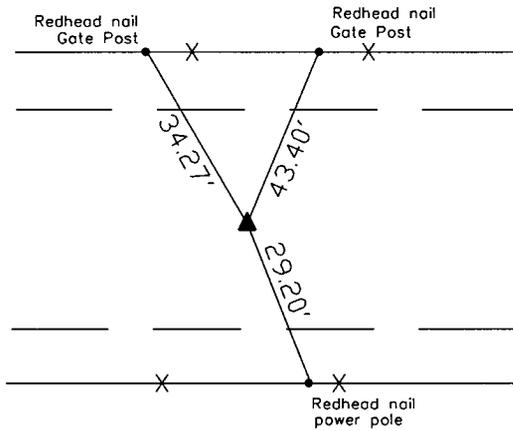

I HEREBY CERTIFY THAT THIS LAND SURVEYING DOCUMENT WAS PREPARED AND THE RELATED SURVEY WORK WAS PERFORMED BY ME OR UNDER MY DIRECT PERSONAL SUPERVISION AND THAT I AM A DULY LICENSED LAND SURVEYOR UNDER THE LAWS OF THE STATE OF IOWA

SIGNATURE: Craig S. Boldman DATE 7-7-11



CRAIG S. BOLDMAN
REGISTRATION NUMBER: 13427

MY LICENSE RENEWAL DATE IS: DECEMBER 31, 2012

LIST CORNERS TO BE INDEXED

Corners	Section	Township	Range
SE Cor	13	74	29
SW Cor	18	74	29
NE Cor	24	74	29
NW Cor	19	74	29

SEAL

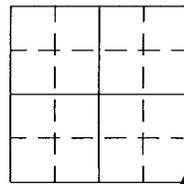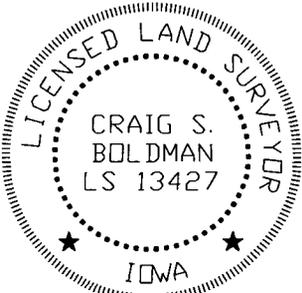

Project No. 11005