



Document 2011 GW2060

Book 2011 Page 2060 Type 43 001 Pages 4

Date 8/03/2011 Time 1:22 PM

Rec Amt \$.00

INDX ✓  
ANNO  
SCAN

LISA SMITH, COUNTY RECORDER  
MADISON COUNTY IOWA

CHEK

**REAL ESTATE TRANSFER - GROUNDWATER HAZARD STATEMENT  
TO BE COMPLETED BY TRANSFEROR**

**TRANSFEROR:**

Name Daniel J. King and Sara R. King

Address 1061 State Highway 92, Winterset, Iowa 50273

Number and Street or RR City, Town or P.O. State Zip

**TRANSFeree:**

Name Jesse L. Vais

Address 2747 340<sup>th</sup> Street, Anita, Iowa 50020

Number and Street or RR City, Town or P.O. State Zip

**Address of Property Transferred:**

Vacant Land

Number and Street or RR City, Town or P.O. State Zip

Legal Description of Property: The SW ¼ SE ¼ of Section 6, Township 75, Range 29 West of the 5<sup>th</sup> P.M., Madison County, Iowa; EXCEPT that part thereof deeded to State of Iowa for Highway purposes in Warranty Deed dated July 1, 1966, and filed on October 10, 1966, in Deed Record 94, Page 347, in Office of the Recorder of Madison County, Iowa; AND EXCEPT Parcel "C" containing 5.00 acres, as shown in Plat of Survey filed in Book 2007, Page 1566 on April 17, 2007 in the Office of the Recorder of Madison County, Iowa; AND Parcel "D", a part of Parcel "C", located in the SW ¼ SE ¼ of Section 6, Township 75, Range 29 West of the 5<sup>th</sup> P.M., Madison County, Iowa, containing 1.95 acres as shown in the Plat of Survey filed in Book 2011, Page 1612 on June 20, 2011, in the Office of the Recorder of Madison County, Iowa.

**1. Wells (check one)**

*Attached*  There are no known wells situated on this property.  
 There is a well or wells situated on this property. The type(s), location(s) and legal status are stated below or set forth on an attached separate sheet, as necessary.

**2. Solid Waste Disposal (check one)**

There is no known solid waste disposal site on this property.  
 There is a solid waste disposal site on this property and information related thereto is provided in Attachment #1, attached to this document.

**3. Hazardous Wastes (check one)**

There is no known hazardous waste on this property.

There is hazardous waste on this property and information related thereto is provided in Attachment #1, attached to this document.

**4. Underground Storage Tanks (check one)**

There are no known underground storage tanks on this property. (Note exclusions such as small farm and residential motor fuel tanks, most heating oil tanks, cisterns and septic tanks, in instructions.)

There is an underground storage tank on this property. The type(s), size(s) and any known substance(s) contained are listed below or on an attached separate sheet, as necessary.

**5. Private Burial Site (check one)**

There are no known private burial sites on this property.

There is a private burial site on this property. The location(s) of the site(s) and known identifying information of the decedent(s) is stated below or on an attached separate sheet, as necessary.

**6. Private Sewage Disposal System (check one)**

All buildings on this property are served by a public or semi-public sewage disposal system.

This transaction does not involve the transfer of any building.

There is a building served by private sewage disposal system on this property or a building without any lawful sewage disposal system. A certified inspector's report is attached which documents the condition of the private sewage disposal system and whether any modifications are required to conform to standards adopted by the Department of Natural Resources. A certified inspection report must be accompanied by this form when recording.

There is a building served by private sewage disposal system on this property. Weather or other temporary physical conditions prevent the certified inspection of the private sewage disposal system from being conducted. The buyer has executed a binding acknowledgment with the county board of health to conduct a certified inspection of the private sewage disposal system at the earliest practicable time and to be responsible for any required modifications to the private sewage disposal system as identified by the certified inspection. A copy of the binding acknowledgment is attached to this form.

There is a building served by private sewage disposal system on this property. The buyer has executed a binding acknowledgment with the county board of health to install a new private sewage disposal system on this property within an agreed upon time period. A copy of the binding acknowledgment is provided with this form.

There is a building served by private sewage disposal system on this property. The building to which the sewage disposal system is connected will be demolished without being occupied. The buyer has executed a binding acknowledgment with the county board of health to demolish the building within an agreed upon time period. A copy of the binding acknowledgment is provided with this form.


[Exemption #9]

This property is exempt from the private sewage disposal inspection requirements pursuant to the following exemption [Note: for exemption #9 use prior check box]: \_\_\_\_\_.

The private sewage disposal system has been installed within the past two years pursuant to permit number \_\_\_\_\_.

**Information required by statements checked above should be provided here or on separate sheets attached hereto:**

**I HEREBY DECLARE THAT I HAVE REVIEWED THE INSTRUCTIONS FOR THIS FORM AND THAT THE INFORMATION STATED ABOVE IS TRUE AND CORRECT.**

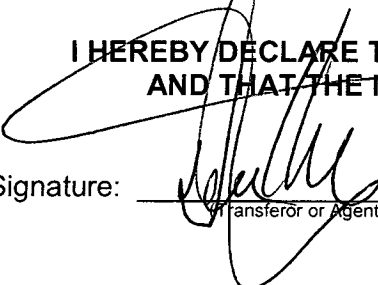Signature: 

(Transferor or Agent) DANIEL J. KING


Telephone No.: 515-537-4814

## EXHIBIT "A"

The SW  $\frac{1}{4}$  SE  $\frac{1}{4}$  of Section 6, Township 75, Range 29 West of the 5<sup>th</sup> P.M., Madison County, Iowa; EXCEPT that part thereof deeded to State of Iowa for Highway purposes in Warranty Deed dated July 1, 1966, and filed on October 10, 1966, in Deed Record 94, Page 347, in Office of the Recorder of Madison County, Iowa; AND EXCEPT Parcel "C" containing 5.00 acres, as shown in Plat of Survey filed in Book 2007, Page 1566 on April 17, 2007 in the Office of the Recorder of Madison County, Iowa;

AND


Parcel "D", a part of Parcel "C", located in the SW  $\frac{1}{4}$  SE  $\frac{1}{4}$  of Section 6, Township 75, Range 29 West of the 5<sup>th</sup> P.M., Madison County, Iowa, containing 1.95 acres as shown in the Plat of Survey filed in Book 2011, Page 1612 on June 20, 2011, in the Office of the Recorder of Madison County, Iowa.

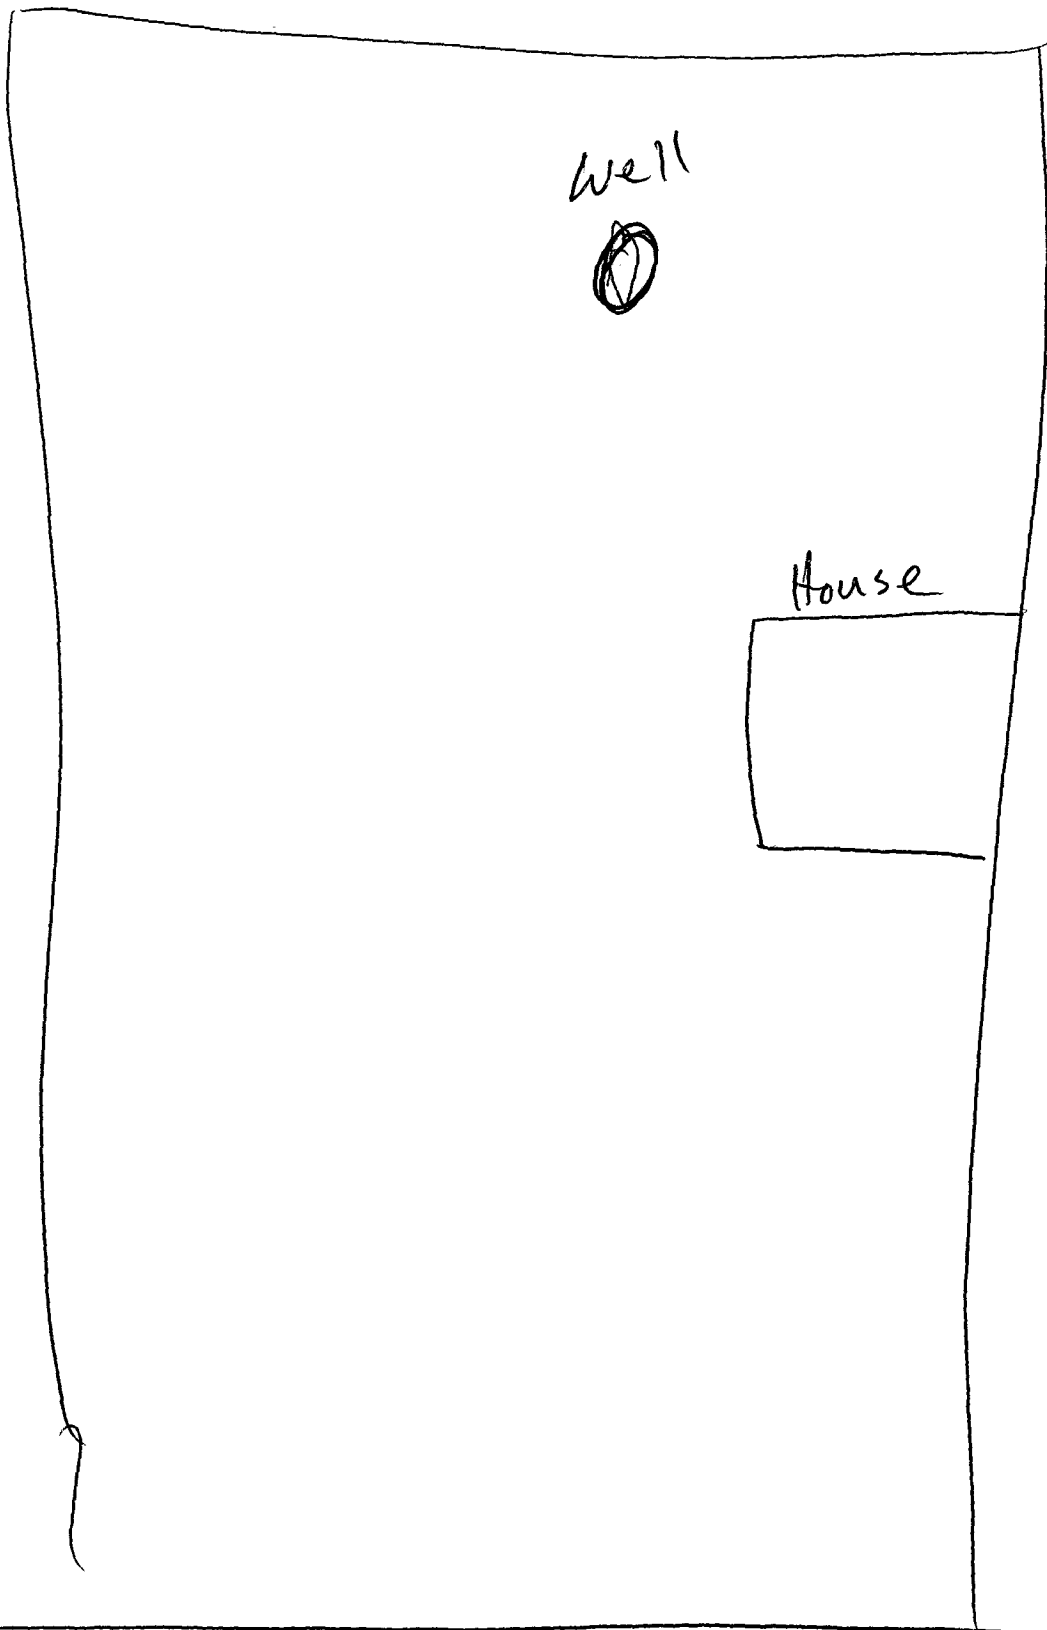

Well



House

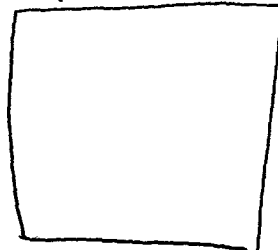

Aug 92

Adair - Madison Ave