Document 2011 2204

Book 2011 Page 2204 Type 06 043 Pages 1
Date 8/18/2011 Time 1:55 PM
Rec Amt $7.00

INDX
ANNO
SCAN

LISA SMITH, COUNTY RECORDER
MADISON COUNTY IOWA

CHEK

VANCE & HOCHSTETLER,P.C. CONSULTING ENGINEERS, WINTERSET, IOWA (515)462-3995

CHARLES T. VANCE, 110 WEST GREEN ST.,WINTERSET, IOWA 50273
JAMES M. HOCHSTETLER, 110 WEST GREEN ST., WINTERSET, IOWA 50273

11-985

# UNITED STATES PUBLIC LAND SURVEY CORNER CERTIFICATE

OF


Land Survey Monuments situated in Section 6, Township 74 N, Range 29W, of the Fifth Principal Meridian, MADISON County, Iowa.
Previously recorded in _____ (book, page, document number, etc.) in County Recorder's Office.

(Show reason for preparing this certificate, the evidence and detailed procedures used in establishing the corner positions and monumentation found or placed.)

Monument Description and Remarks: N.E.COR. SE¼NE¼ - Set yellow CIR #6808 in line with ℄ road to West on line between found NE Cor. & E¼ Cor. Could not find any records of road dedication but the current location has been used as be the South line of the N½ NE¼ Fr¼ in the transfer of land on both the North & South side of the road. NW Cor SW¼NE¼ - Set yellow CIR # 6808 in line with ℄ road to East and on line between found N¼ Cor. and ℄ road at approximate SW COR. NW¼SE¼.

PLAN - VIEW

(Show a minimum of three reference ties to durable physical objects, relevant monuments and physical conditions that will enable recovery of the corner.)

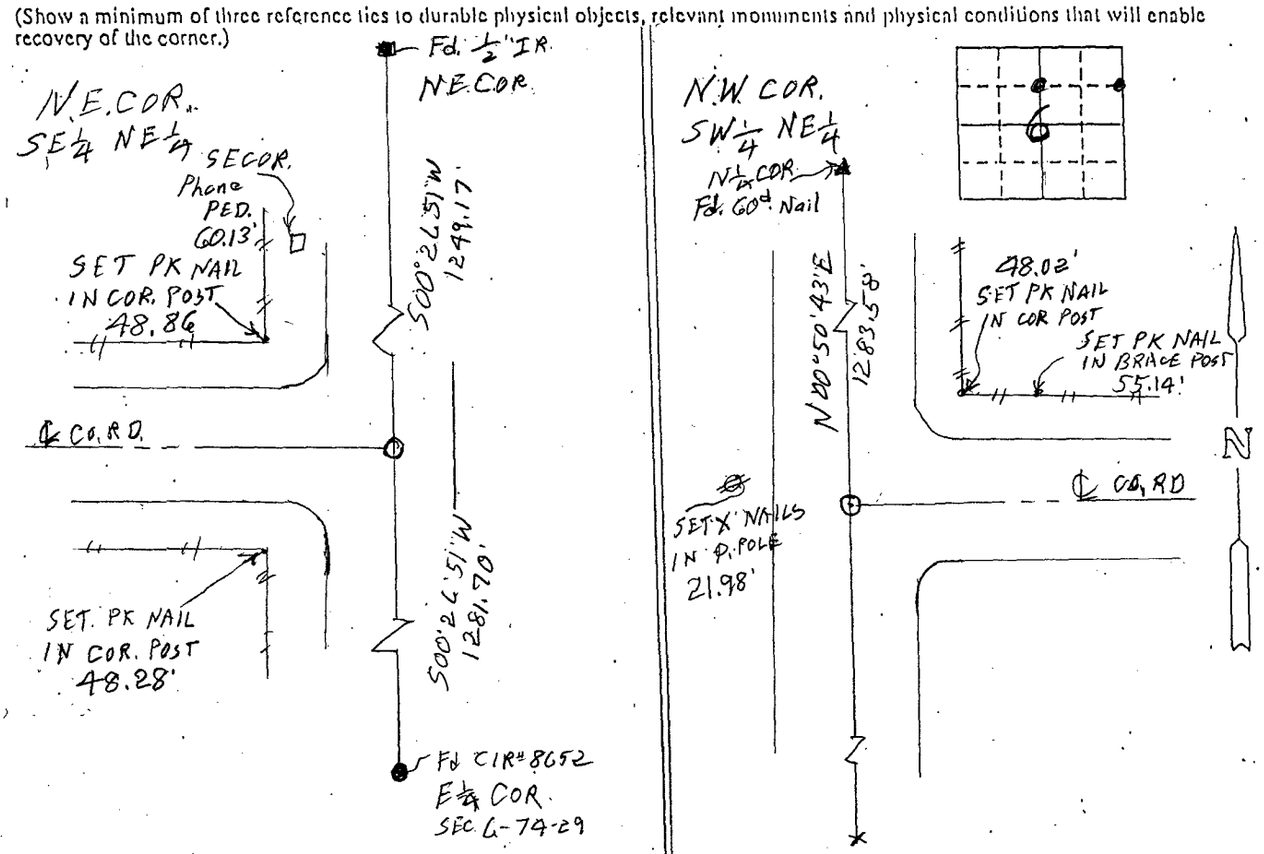


LICENSED LAND SURVEYOR
J. M. HOCHSTETLER #6808
IOWA

I hereby certify that this land surveying document was prepared and the related survey work was performed by me or under my direct personal supervision and that I am a duly licensed Land Surveyor under the laws of the State of Iowa.

J.M. Hochstetler

J.M. HOCHSTETLER
License number 6808 Date 8/12/11
My license renewal date is December 31 2011
Pages or sheets covered by this seal: 1

List Corners to be Indexed

| Corners | Section | Twp | Range |
|---|---|---|---|
| NE COR, SE¼ NE¼ | 6 | 74N | 29W |
| NW COR, SW¼ NE¼ | 6 | 74N | 29W |