Document 2011 2725

Book 2011 Page 2725 Type 06 043 Pages 1
Date 10/14/2011 Time 8:07 AM
Rec Amt $7.00

INDX ✓
ANNO
SCAN
CHEK

LISA SMITH, COUNTY RECORDER
MADISON COUNTY IOWA

ANCE & HOCHSTETLER, P.C. CONSULTING ENGINEERS, WINTERSET, IOWA (515)462-3995
CHARLES T. VANCE, 110 WEST GREEN ST., WINTERSET, IOWA 50273
JAMES M. HOCHSTETLER, 110 WEST GREEN ST., WINTERSET, IOWA 50273

1185

UNITED STATES PUBLIC LAND SURVEY CORNER CERTIFICATE

OF


Land Survey Monuments situated in Section 20, Township 74 N, Range 27 W, of the Fifth Principal Meridian, MADISON County, Iowa.
Previously recorded in _____ (book, page, document number, etc.) in County Recorder's Office.


(Show reason for preparing this certificate, the evidence and detailed procedures used in establishing the corner positions and monumentation found or placed.)


Monument Description and Remarks: CENTER - Fd. IRON ROD Set in 1985 for Survey of County Conservation Property.
SW COR NW¼SE¼ - Set CIR #6808 @ 3 Way property line fence corner.
SE COR NW¼SE¼ - Set CIR #6808 @ PROPERTY LINE Fence Corner.

PLAN - VIEW

(Show a minimum of three reference ties to durable physical objects, relevant monuments and physical conditions that will enable recovery of the corner.)

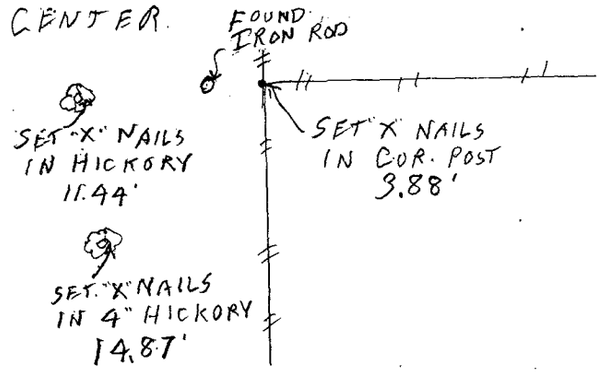

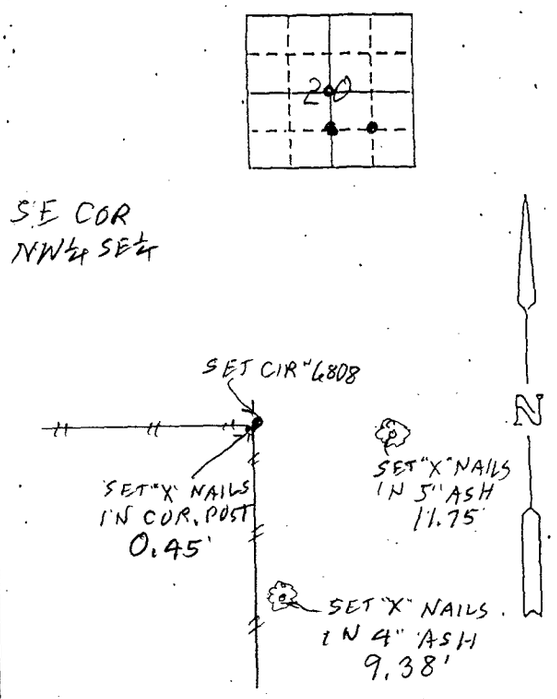

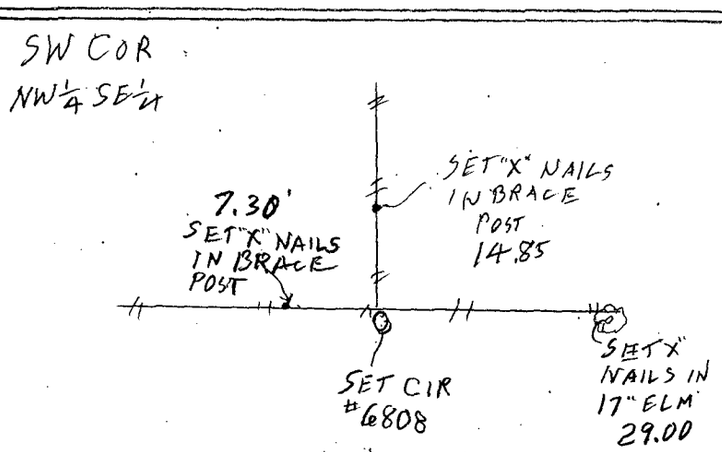

Corners	List Corners to be Indexed Section	Twp	Range
CENTER	20	74N	27W
SW COR NW¼SE¼	20	74N	27W
SE COR NW¼SE¼	20	74N	27W

LICENSED LAND SURVEYOR
J. M. HOCHSTETLER #6808
IOWA

I hereby certify that this land surveying document was prepared and the related survey work was performed by me or under my direct personal supervision and that I am a duly licensed Land Surveyor under the laws of the State of Iowa.

J. M. HOCHSTETLER
License number 6808 Date 10/10/11
My license renewal date is December 31, 2011
Pages or sheets covered by this seal: 1