Document 2011 2726

Book 2011 Page 2726 Type 06 043 Pages 1
Date 10/14/2011 Time 8:08 AM
Rec Amt $7.00

INDX
ANNO
SCAN

LISA SMITH, COUNTY RECORDER
MADISON COUNTY IOWA

CHEK

VANCE & HOCHSTETLER, P.C. CONSULTING ENGINEERS, WINTERSET, IOWA (515)462-3995

CHARLES T. VANCE, 110 WEST GREEN ST., WINTERSET, IOWA 50273
JAMES M. HOCHSTETLER, 110 WEST GREEN ST., WINTERSET, IOWA 50273

1-1185

UNITED STATES PUBLIC LAND SURVEY CORNER CERTIFICATE

OF

Land Survey Monuments situated in Section 28, Township 74 N, Range 27 W, of the Fifth Principal Meridian, MADISON County, Iowa.


Previously recorded in _____ (book, page, document number, etc.) in County Recorder's Office.

(Show reason for preparing this certificate, the evidence and detailed procedures used in establishing the corner positions and monumentation found or placed.)

Monument Description and Remarks: SW COR SE¼SW¼ - Set yellow CIR #6808 at mid point on line between found N ¼ Cor and set SW COR. NE COR SE¼SW¼ - Set yellow CIR #6808 at old property line fence intersection. W ¼ Cor - Found yellow CIR #6808 Set in 1985 for Survey of County Conservation property.

PLAN - VIEW

(Show a minimum of three reference ties to durable physical objects, relevant monuments and physical conditions that will enable recovery of the corner.)

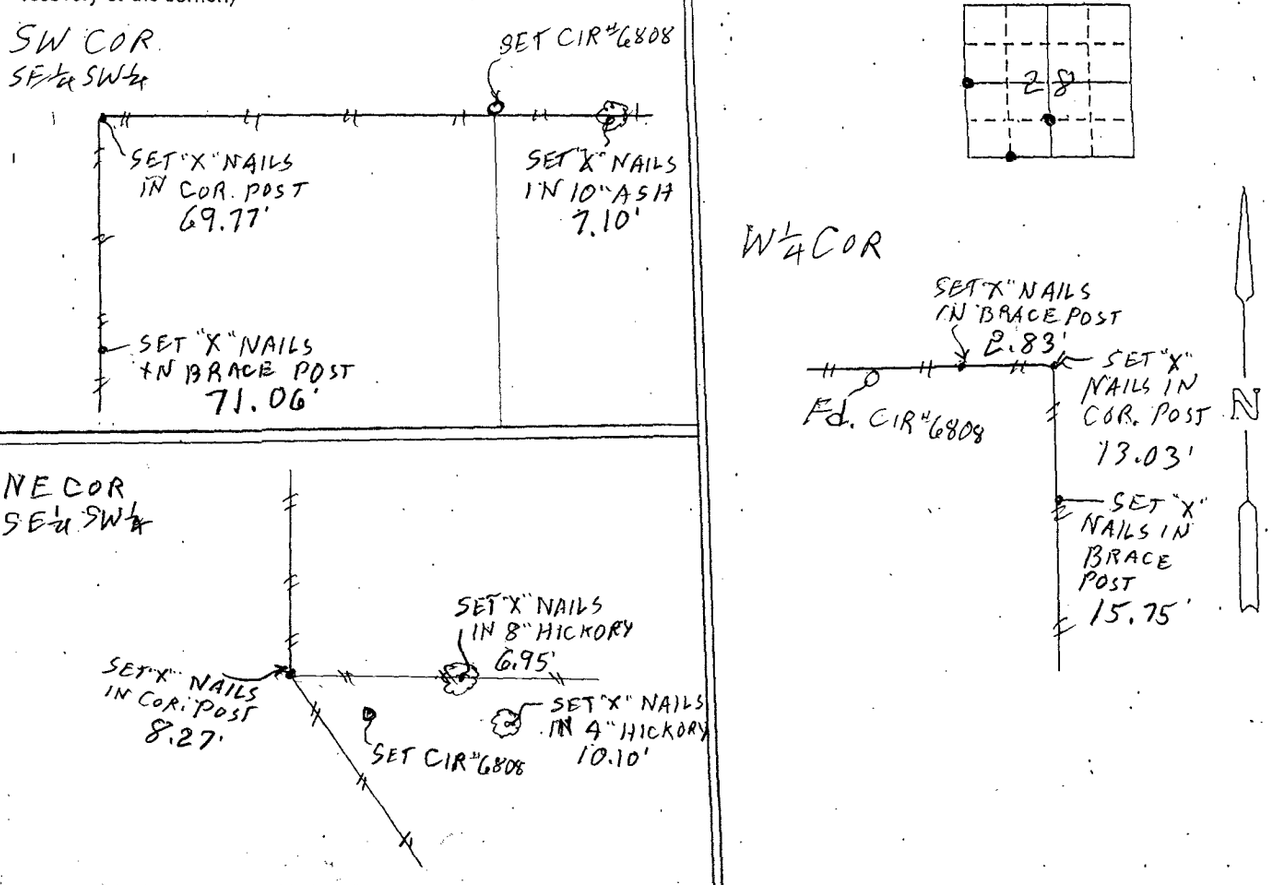

Corners	List Corners to be Indexed Section	Twp	Range
SW COR SE¼SW¼	28	74N	27W
NE COR SE¼SW¼	28	74N	27W
W¼COR	28	74N	27W

LICENSED LAND SURVEYOR
J. M. HOCHSTETLER
#6808
IOWA

I hereby certify that this land surveying document was prepared and the related survey work was performed by me or under my direct personal supervision and that I am a duly licensed Land Surveyor under the laws of the State of Iowa.

J M Hochstetler
J.M. HOCHSTETLER
License number 6808 Date 10/10/11
My license renewal date is December 31, 2011
Pages or sheets covered by this seal: 1