



Document 2011 2722

Book 2011 Page 2722 Type 06 026 Pages 1

Date 10/14/2011 Time 8:04 AM

Rec Amt \$7.00

INDX
ANNO
SCAN
CHEK



LISA SMITH, COUNTY RECORDER
MADISON COUNTY IOWA

VANCE & HOCHSTETLER, P.C. • CONSULTING ENGINEERS • WINTERSET, IOWA 50273

11-125s


CHARLES T. VANCE • 110 WEST GREEN ST., WINTERSET, IOWA • (515) 462-3995
JAMES M HOCHSTETLER • 110 WEST GREEN ST., WINTERSET, IOWA • FAX: (515) 462-9845

PLAT OF SURVEY OF LOT 5, BLOCK 10, PITZER & KNIGHT'S ADDITION
TO THE CITY OF WINTERSET, MADISON COUNTY, IOWA
OWNED BY THOMAS D. & CINDY M. BUSH.

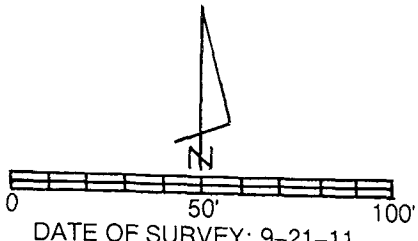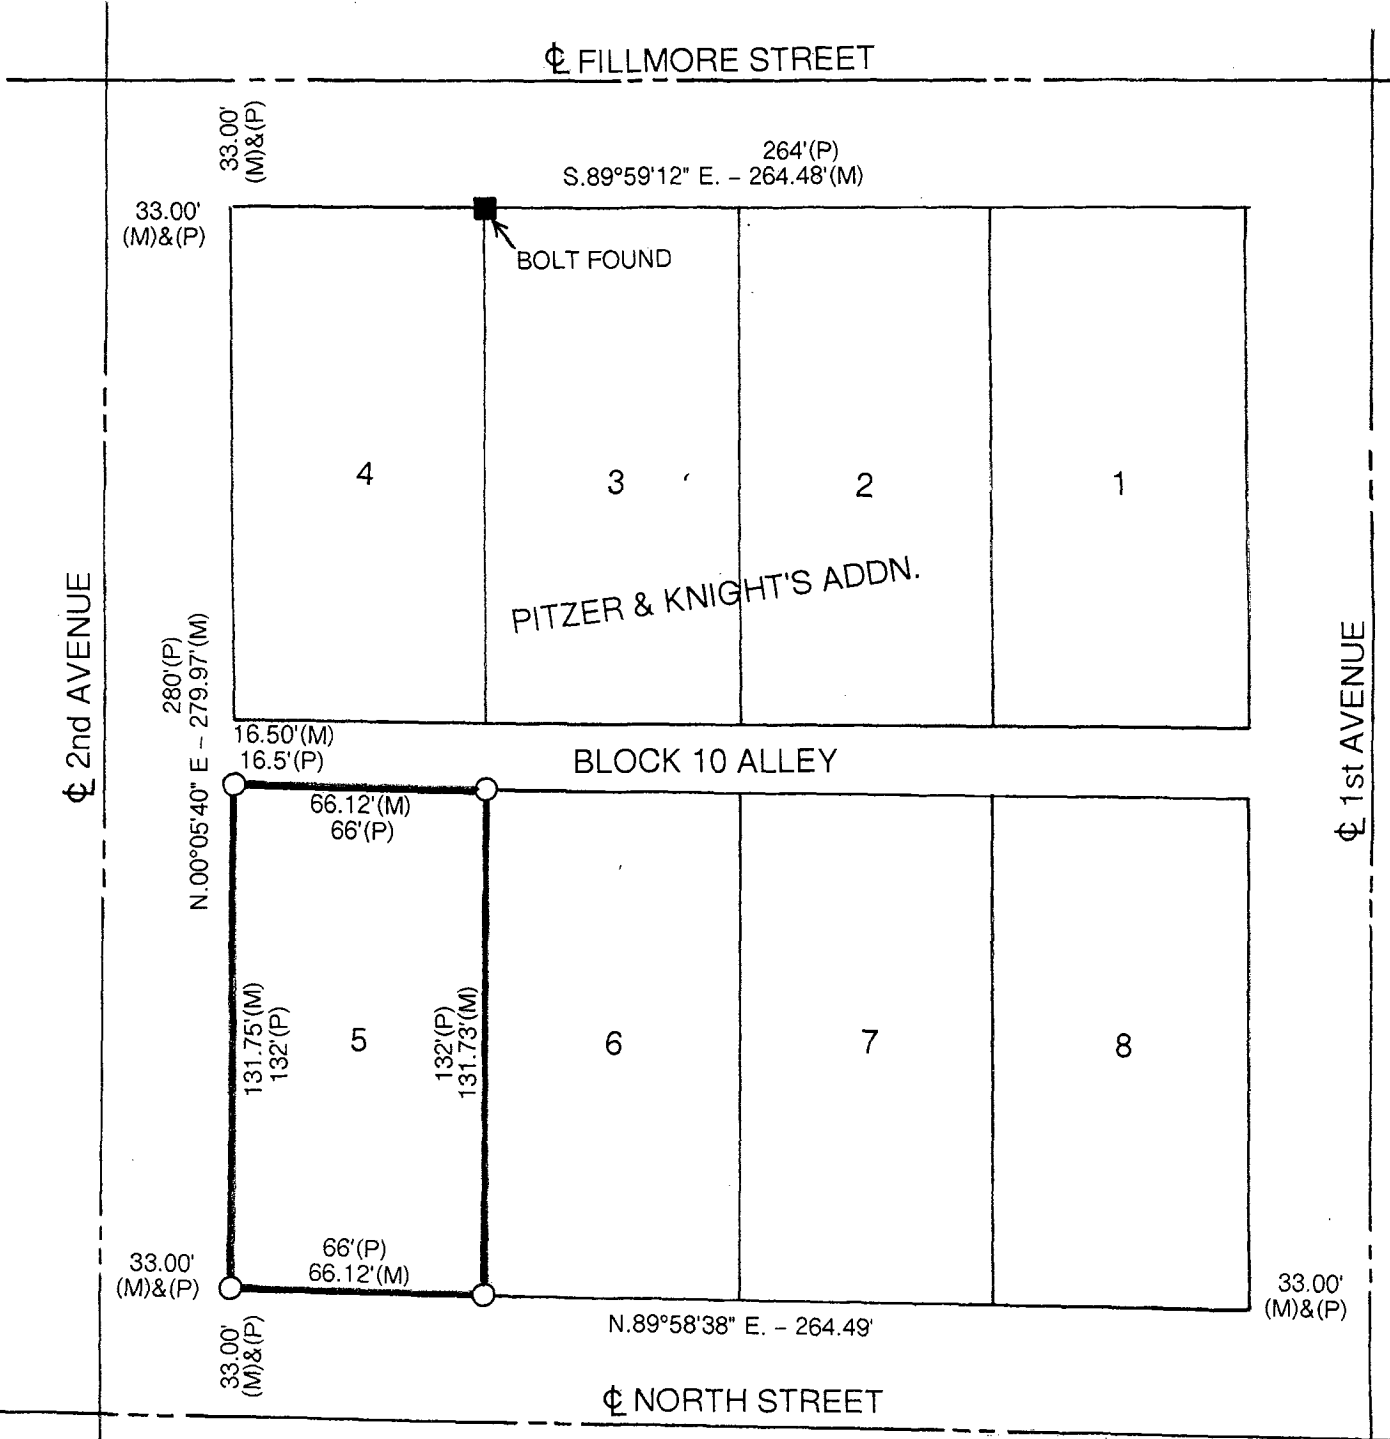

DATE OF SURVEY: 9-21-11

- CAPPED IRON ROD (CIR) #6808 SET
- 1/2' IRON ROD FOUND
- BOLT FOUND
- (M) MEASURED
- (P) PLATED

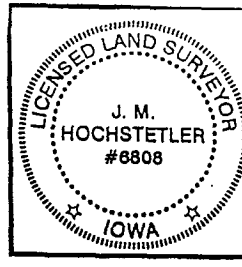

I hereby certify that this land surveying document was prepared and the related survey work was performed by me or under my direct personal supervision and that I am a duly licensed Land Surveyor under the laws of the State of Iowa.

J. M. Hochstetler
J.M. HOCHSTETLER
License number 6808 Date 9/26/11
My license renewal date is December 31, 2011
Pages or sheets covered by this seal: 1