Document 2011 3034

Book 2011 Page 3034 Type 06 043 Pages 1
Date 11/10/2011 Time 10:34 AM
Rec Amt $7.00

INDX ✓
ANNO
SCAN
CHEK

LISA SMITH, COUNTY RECORDER
MADISON COUNTY IOWA

VANCE & HOCHSTETLER, P.C. CONSULTING ENGINEERS, WINTERSET, IOWA (515)462-3995

CHARLES T. VANCE, 110 WEST GREEN ST., WINTERSET, IOWA 50273
JAMES M. HOCHSTETLER, 110 WEST GREEN ST., WINTERSET, IOWA 50273

11-1275

UNITED STATES PUBLIC LAND SURVEY CORNER CERTIFICATE

OF


Land Survey Monuments situated in Section 9, Township 75N, Range 29W, of the Fifth Principal Meridian, MADISON County, Iowa.
Previously recorded in _____ (book, page, document number, etc.) in County Recorder's Office.

(Show reason for preparing this certificate, the evidence and detailed procedures used in establishing the corner positions and monumentation found or placed.)

Monument Description and Remarks: NW Cor. SE¼NE¼ – Set yellow CIR #6808 at old property line fence corner. SW Cor. SE¼NE¼ – Set yellow CIR #6808 in North-South property line fence at midpoint between set NW Cor SE¼NE¼ and property line fence West at SW Cor. NE¼SE¼. SW Cor. NE¼SE¼ – Set yellow CIR #6808 in line with property line fence West and projection of line from Set SW Cor SE¼NE¼ through existing fence North of Road.

PLAN - VIEW

(Show a minimum of three reference ties to durable physical objects, relevant monuments and physical conditions that will enable recovery of the corner.)

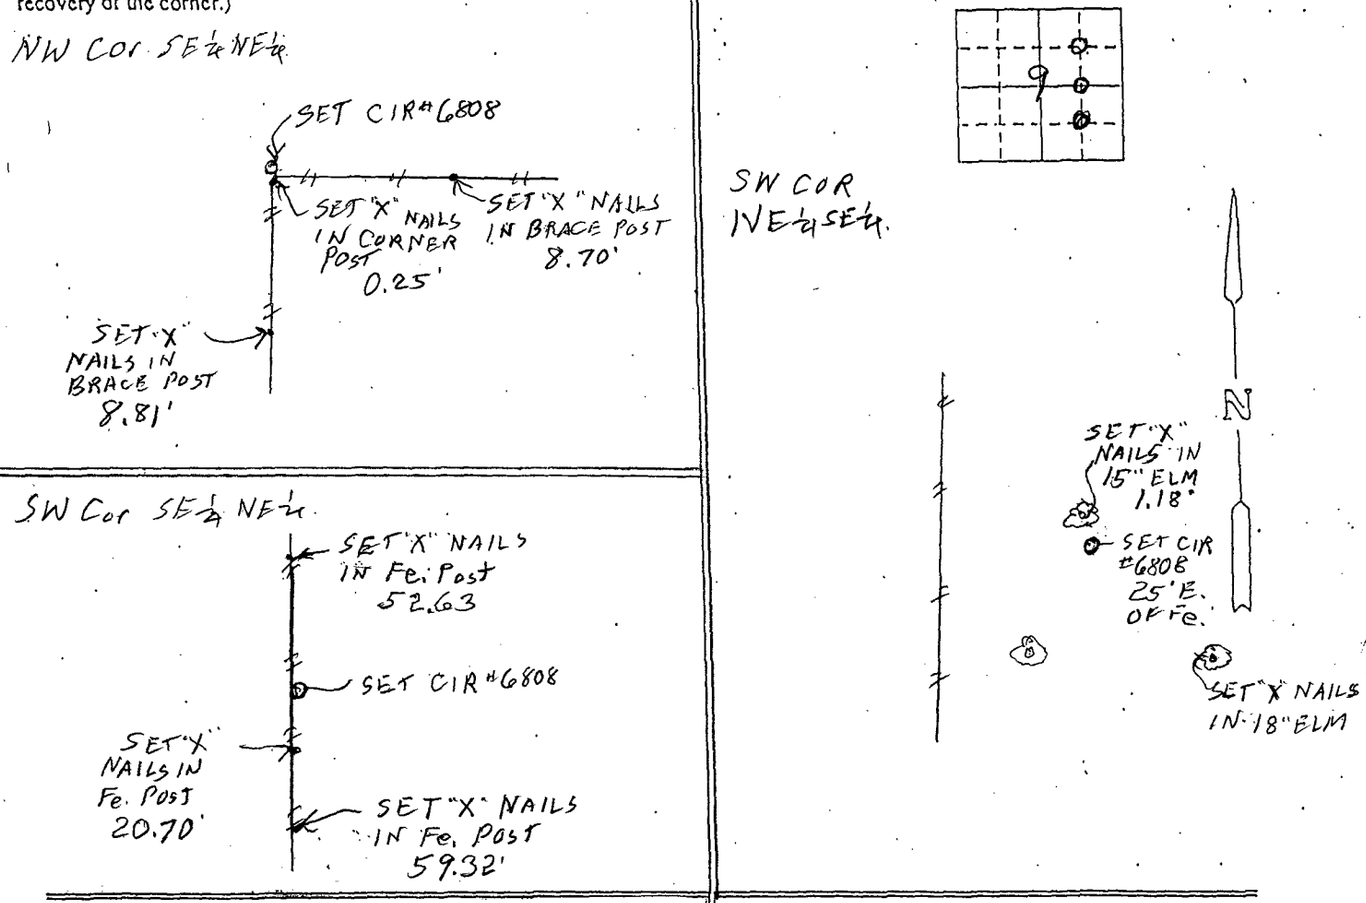

Corners	List Corners to be Indexed Section	Twp	Range
NW COR SE¼NE¼	9	75N	29W
SW COR SE¼NE¼	9	75N	29W
SW COR NE¼SE¼	9	75N	29W

LICENSED LAND SURVEYOR
J. M. HOCHSTETLER
#6808
IOWA

I hereby certify that this land surveying document was prepared and the related survey work was performed by me or under my direct personal supervision and that I am a duly licensed Land Surveyor under the laws of the State of Iowa.

J.M. Hochstetler
J.M. HOCHSTETLER
License number 6808 Date 10/4/11
My license renewal date is December 31, 2011
Pages or sheets covered by this seal: 1