Document 2011 3154

Book 2011 Page 3154 Type 06 043 Pages 1
Date 11/23/2011 Time 1:46 PM
Rec Amt $7.00

INDX
ANNO
SCAN

LISA SMITH, COUNTY RECORDER
MADISON COUNTY IOWA


CHEK

Prepared by: Boldman Surveying Consultants 521 West Green St.Winterset, IA0273 Phone (515)462-9242

UNITED STATES PUBLIC LAND SURVEY CORNER CERTIFICATE

Land Survey Monuments situated in Section 35, Township 75, Range 29, the Fifth Principal Meridian, Madison County, Iowa.
Previously recorded in NONE FOUND in County Recorder's Office
Monument Description and Remarks: NE cor– R.A. Patterson (1874),E.B.Hiatt (1922) indicate that the NE sec corner was not found. Corner was reestablished using fencelines and road centerline. E 1/4–R.A Patterson (1874) indicates stone set in orignal mound. Search area for stone found nothing. Set nail in top of old corner post and tied off. W 1/4– R.A. Patterson (1874) set stone for corner. E.B.Hiatt(1922) indicates 1/2"bar.Searched area with metal detector found nothing.Set track spike at midpoint on line between SW and NW sec corners.

PLAN–VIEW

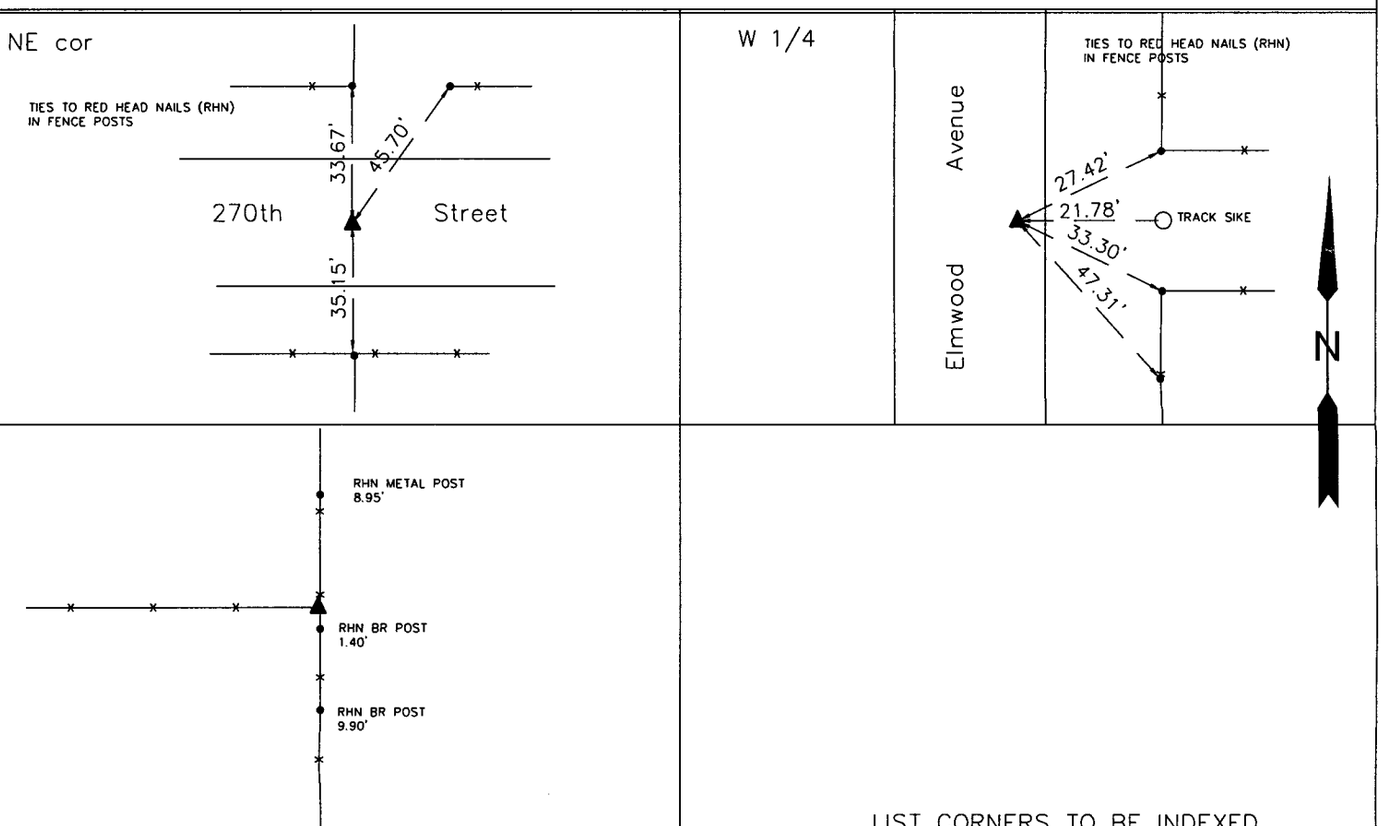

LIST CORNERS TO BE INDEXED

I HEREBY CERTIFY THAT THIS LAND SURVEYING DOCUMENT WAS PREPARED AND THE RELATED SURVEY WORK WAS PERFORMED BY ME OR UNDER MY DIRECT PERSONAL SUPERVISION AND THAT I AM A DULY LICENSED LAND SURVEYOR UNDER THE LAWS OF THE STATE OF IOWA.


SIGNATURE: _____ DATE 11-21-11

CRAIG S. BOLDMAN


REGISTRATION NUMBER: 13427

MY LICENSE RENEWAL DATE IS: DECEMBER 31, 2012

SEAL

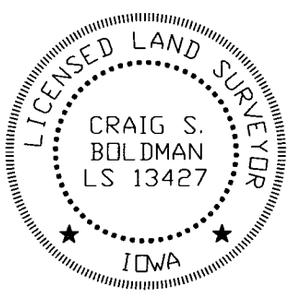

Corners	Section	Township	Range
NE	35	75	29
NW	36		
SE	26		
SW	25		
W1/4	35		
E1/4	34		
E1/4	35		
W1/4	36		

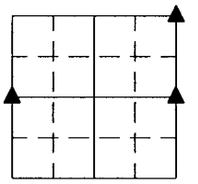

Project No.11044