Document 2012 501

Book 2012 Page 501 Type 06 043 Pages 1
Date 2/17/2012 Time 12:36 PM
Rec Amt $7.00

INDX ✓
ANNO
SCAN
CHEK

LISA SMITH, COUNTY RECORDER
MADISON COUNTY IOWA

VANCE & HOCHSTETLER, P.C. CONSULTING ENGINEERS, WINTERSET, IOWA (515)462-3995
245 CHARLES T. VANCE, 110 WEST GREEN ST., WINTERSET, IOWA 50273
JAMES M. HOCHSTETLER, 110 WEST GREEN ST., WINTERSET, IOWA 50273

UNITED STATES PUBLIC LAND SURVEY CORNER CERTIFICATE

OF


Land Survey Monuments situated in Section 8, Township 75 North, Range 28 West, of the Fifth Principal Meridian, Madison County, Iowa.
Previously recorded in N/A (book, page, document number, etc.) in County Recorder's Office.


(Show reason for preparing this certificate, the evidence and detailed procedures used in establishing the corner positions and monumentation found or placed.)

Monument Description and Remarks: Set Center Cor. at intersection of East-West 1/4 Sec. Line and extended 1/4 Sec. Line from South. Set SW. Cor. of NE 1/4 SW 1/4 at intersection of East-West 1/4 1/4 Sec. Line and the North-South 1/4 1/4 Sec. Line.

PLAN - VIEW

(Show a minimum of three reference ties to durable physical objects, relevant monuments and physical conditions that will enable recovery of the corner.)

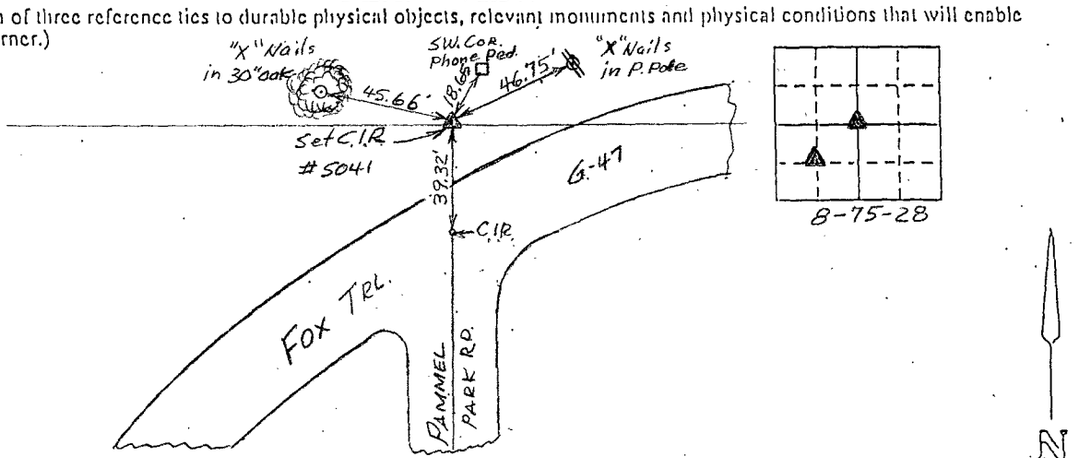

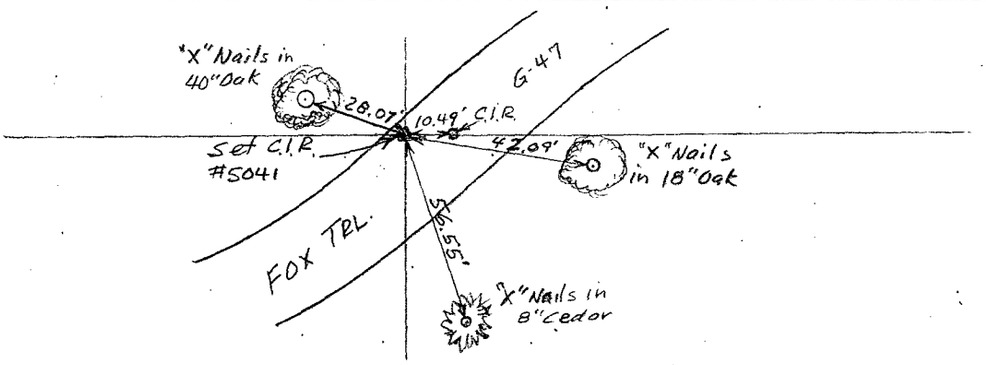

PROFESSIONAL ENGINEER LICENSED CHARLES T. VANCE 5041 IOWA LAND SURVEYOR

I hereby certify that this land surveying document was prepared and the related survey work was preformed by me or under my direct personal supervision and that I am a duly Licensed Land Surveyor under the laws of the State of Iowa.

Charles T. Vance 31 Jan. 2012
Charles T. Vance, PE & PLS — Date

License No. 5041

My License renewal date is 31, December 2013

List Corners to be Indexed

Corners	Section	Twp	Range
CENTER	8	75	28
SW. COR. NE 1/4 SW 1/4	8	75	28