

Document 2012 725


Book 2012 Page 725 Type 06 026 Pages 2 Date 3/12/2012 Time 10:46 AM

Rec Amt \$12.00

INDX V ANNO SCAN

CHEK

LISA SMITH, COUNTY RECORDER MADISON COUNTY IOWA

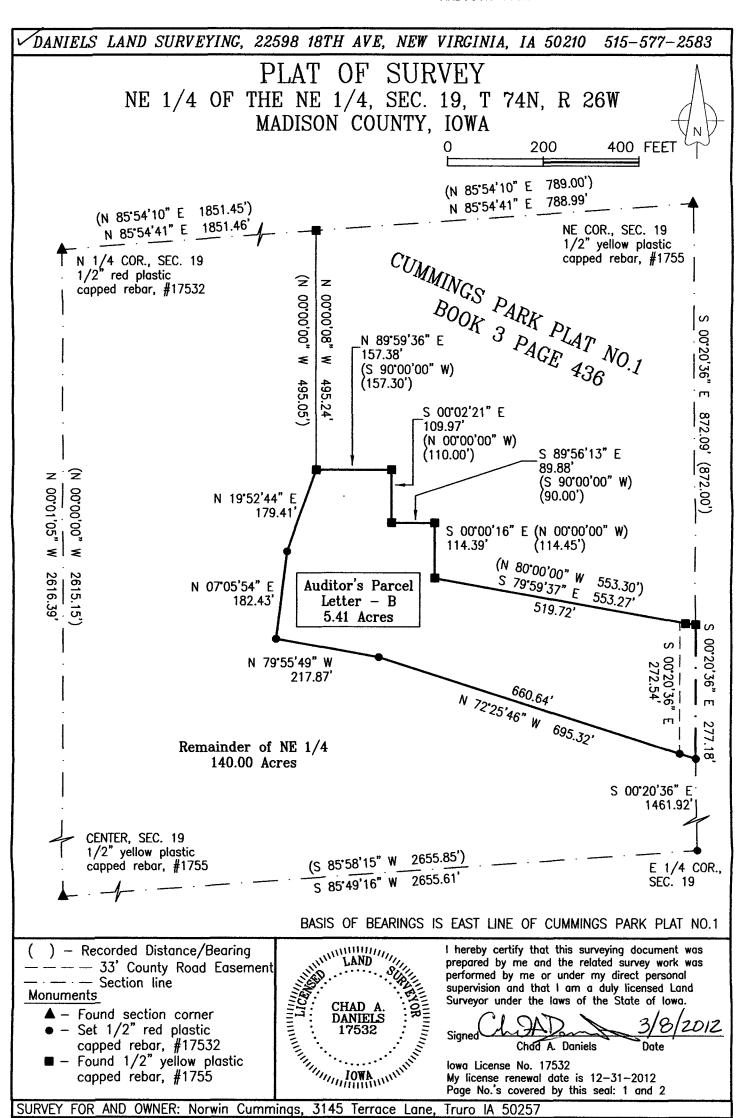

DATE OF SURVEY:

03/03/2012

PAGE 1 of

PROJ. NO. 329

PLAT OF SURVEY NE 1/4 OF THE NE 1/4, SEC. 19, T 74N, R 26W MADISON COUNTY, IOWA



DESCRIPTION - PARCEL B:

That part of the Northeast Quarter of the Northeast Quarter of Section 19, Township 74 North, Range 26 West of the 5th P.M., Madison County, lowa, described as follows;

Commencing at the Northeast corner of said Section 19; thence South 00 degrees 20 minutes 36 seconds East, 872.09 feet to the southeast corner of Cummings Park Plat No. 1, an official plat of Madison County recorded in Book 3 Page 436, and the point of beginning; thence South 00 degrees 20 minutes 36 seconds East, 277.18 feet; thence North 72 degrees 25 minutes 46 seconds West, 695.32 feet; thence North 79 degrees 55 minutes 49 seconds West, 217.87 feet; thence North 07 degrees 05 minutes 54 seconds East, 182.43 feet; thence North 19 degrees 52 minutes 44 seconds East, 179.41 feet to a corner of said Cummings Park Plat No. 1; thence North 89 degrees 59 minutes 36 seconds East, 157.38 feet to a corner of said Cummings Park Plat No. 1; thence South 00 degrees 02 minutes 21 seconds East, 109.97 feet to a corner of said Cummings Park Plat No. 1; thence South 89 degrees 56 minutes 13 seconds East, 89.88 feet to a corner of said Cummings Park Plat No. 1; thence South 00 degrees 00 minutes 16 seconds East, 114.39 feet to a corner of said Cummings Park Plat No. 1; thence South 79 degrees 59 minutes 37 seconds East, 553.27 feet to the point of beginning, having an area of 5.41 acres including 0.21 acres of Madison County Road Easement.

SURVEY FOR AND OWNER: Norwin Cummings, 3145 Terrace Lane, Truro IA 50257 PROJ. NO. 329