Document 2012 796

Book 2012 Page 796 Type 06 043 Pages 1
Date 3/19/2012 Time 11:27 AM
Rec Amt $7.00

INDX ✓
ANNO
SCAN
CHEK

LISA SMITH, COUNTY RECORDER
MADISON COUNTY IOWA

PREPARED BY - CLAPSADDLE-GARBER ASSOCIATES, INC, 16 EAST MAIN STREET, P.O. BOX 754, MARSHALLTOWN, IOWA 50158 - PHONE 641-752-6701

UNITED STATES PUBLIC LAND SURVEY CORNER CERTIFICATE OF


Land Survey Monuments situated in Section 24 **, Township** 74 NORTH **, Range** 26 WEST **, of the Fifth Principal Meridian,** MADISON **County, Iowa.**

Previously recorded in Book _____ **, Page** _____ **, Instrument #** _____

THIS CERTIFICATE WAS PREPARED BECAUSE THIS CORNER WAS USED DURING A PLAT OF SURVEY IN SECTION 24-74-26, CORNER WAS FOUND OR SET USING METHODS DESCRIBED BELOW.

PLAN-VIEW


NO SCALE

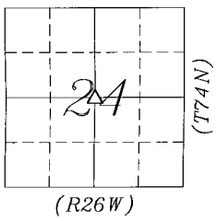

N

LEGEND:

▲	GOVERNMENT CORNER MONUMENT FOUND
△	GOVERNMENT CORNER MONUMENT SET 1/2" x 30" REBAR w/YELLOW PLASTIC ID CAP #15270
////	EXISTING FENCE
NAIL w/SM	NAIL WITH SURVEY MARKER

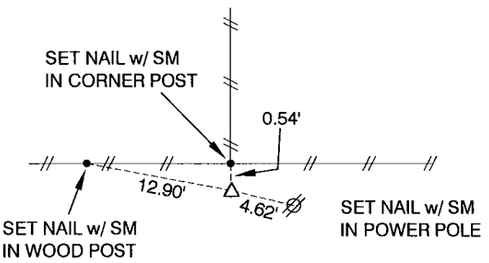

CENTER
SECTION 24-74-26

SET 1/2" x 30" REBAR w/ YELLOW PLASTIC CAP #15270. PROBED AND DUG UP OLD CORNER POST, FOUND NAIL w/ FLAGGING 2" DEEP. NO RECORD MONUMENT, USED NAIL AS LOCATION

CGA
Clapsaddle-Garber Associates, Inc
16 East Main Street
Marshalltown, Iowa 50158
Ph 641 752-6701
www.cgaconsultants.com

DRAWN	SHEET NO.
WLB	1
DATE	PROJECT NO.
3-13-2012	75489.05

List Corners to be Indexed

Corners	Section	Township	Range
CENTER	24	74N	26W

JOSEPH D. FALK LICENSED 15270 IOWA PROFESSIONAL LAND SURVEYOR

I hereby certify that this land surveying document was prepared and the related survey work was performed by me or under my direct personal supervision and that I am a duly Licensed Professional Land Surveyor under the laws of the State of Iowa.

Joseph D. Falk 3-16-12

Joseph D. Falk, PLS — date

Iowa License Number 15270

My License Renewal Date is December 31, 2013

Pages or sheets covered by this seal: THIS SHEET

J:\75489\DWG\75489 Corner Certificates.dwg - Ties SEC 24-74-26 - 03-13-12 - 2:44pm - wlb278