Document 2012 798

Book 2012 Page 798 Type 06 043 Pages 1
Date 3/19/2012 Time 11:29 AM
Rec Amt $7.00

INDX ✓
ANNO
SCAN

LISA SMITH, COUNTY RECORDER
MADISON COUNTY IOWA

CHEK


PREPARED BY - CLAPSADDLE-GARBER ASSOCIATES, INC, 16 EAST MAIN STREET, P.O. BOX 754, MARSHALLTOWN, IOWA 50158 - PHONE 641-752-6701

UNITED STATES PUBLIC LAND SURVEY CORNER CERTIFICATE OF

Land Survey Monuments situated in Section 22 **, Township** 74 NORTH **, Range** 26 WEST **, of the Fifth Principal Meridian,** MADISON **County, Iowa.**

Previously recorded in Book _____ **, Page** _____ **, Instrument #** _____

THIS CERTIFICATE WAS PREPARED BECAUSE THIS CORNER WAS USED DURING A PLAT OF SURVEY IN THE SOUTHWEST 1/4 OF SECTION 22-74-26, CORNER WAS FOUND OR SET USING METHODS DESCRIBED BELOW.

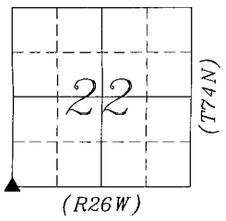


PLAN-VIEW

NO SCALE

N

LEGEND:

▲	GOVERNMENT CORNER MONUMENT FOUND
△	GOVERNMENT CORNER MONUMENT SET 1/2" x 30" REBAR w/YELLOW PLASTIC ID CAP #15270
////	EXISTING FENCE
NAIL w/SM	NAIL WITH SURVEY MARKER

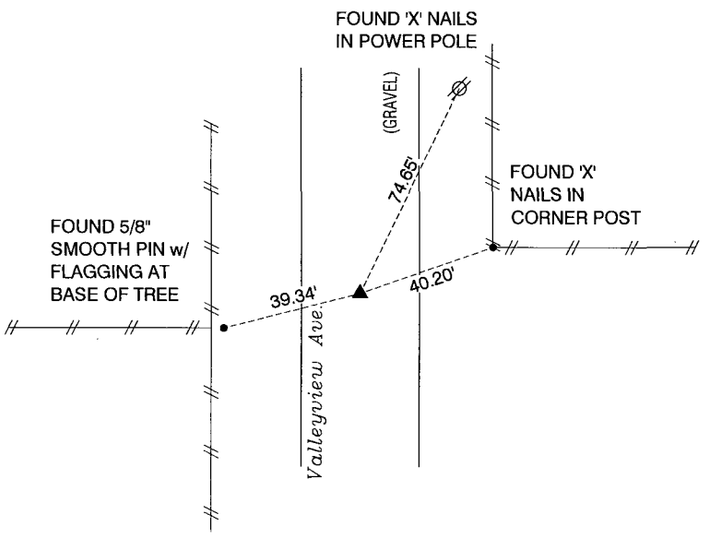

SW CORNER
SECTION 22-74-26

FOUND 1/2" REBAR w/ YELLOW PLASTIC CAP - ILLEGIBLE. TIES OBTAINED FROM COUNTY ENGINEER'S OFFICE

CGA
Clapsaddle-Garber Associates, Inc
16 East Main Street
Marshalltown, Iowa 50158
Ph 641 752-6701
www.cgaconsultants.com

DRAWN	SHEET NO.
WLB	1
DATE	PROJECT NO.
3-13-2012	75489.05

List Corners to be Indexed

Corners	Section	Township	Range
SW COR	22	74N	26W

JOSEPH D. FALK LICENSED 15270 IOWA PROFESSIONAL LAND SURVEYOR

I hereby certify that this land surveying document was prepared and the related survey work was performed by me or under my direct personal supervision and that I am a duly Licensed Professional Land Surveyor under the laws of the State of Iowa.

Joseph D Falk 3-16-12

Joseph D. Falk, PLS — date

Iowa License Number 15270

My License Renewal Date is December 31, 2013

Pages or sheets covered by this seal: THIS SHEET

J:\75489\DWG\75489 Corner Certificates.dwg - Ties SEC 22-74-26 - 03-13-12 - 2:43pm - wlb278