

FILED No. 212
BOOK 2 PAGE 706
96 JUL 23 AM 8:31

MICHELLE UTSLER
RECORDER
MADISON COUNTY, IOWA


REC'D
R.M.P.


Locals:

- A Found Section Corner Monument
- B 5th Section Corner Monument
- C 9th 1/2" Iron Rod with #1208 Cap
- D Iron Set - Tree at Location
- E - Tree at Location

RECORDED
INDEXED
JUL 23 1996

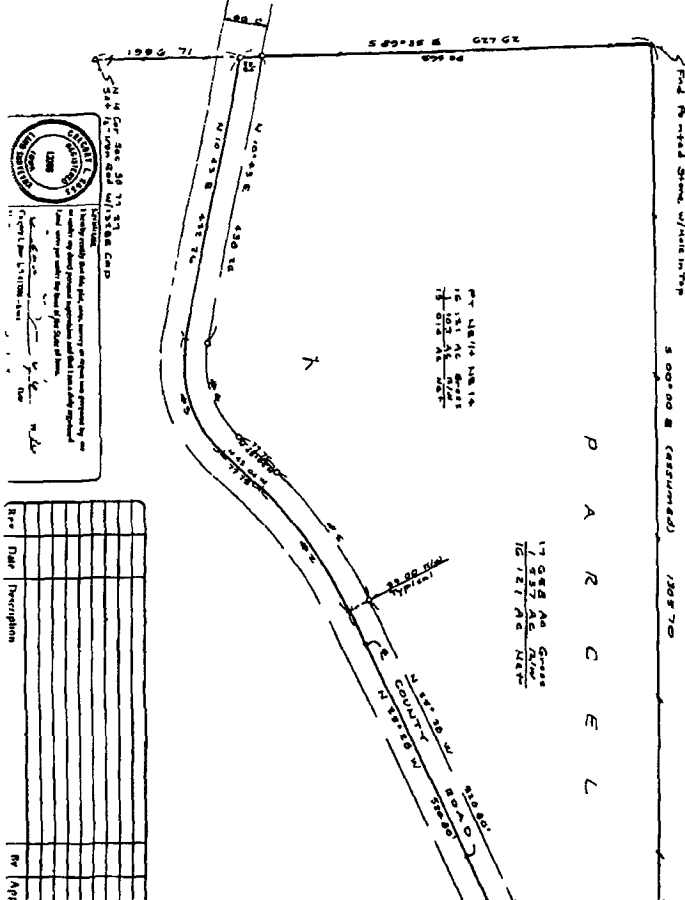

LandTech Services, Inc.
Phone (515) 272-0537

650 Alice Avenue - Suite A, Des Moines, Iowa 50315

PLAT OF SURVEY FOR:
Janis Paulina, RR #4, Winster, IA 50373
NE 1/4 Sec. 26, T7N-R27W, Madison Co., IA

Date: June, 96
Scale: 1"=100'
Drawn by: JJJ
Approved by: CTE

Drawing No. CS97349
Sheet No. 1 of 1

OWNER'S ADDRESS:
