
274 FILED NO BOOK 2 PAGE 96 JUL 29 PH 3: 54 COMPLITER. RECONDED_L MICHELLE UTSLER RECORDER MADISON COUNTY. 10 W/ CO'APARED

VANCE & HOCHSTETLER, P.C. CONSULTING ENGINEERS, WINTERSET, IOWA (515)462-3995

CHARLES T. VANCE, 110 WEST GREEN ST., WINTERSET, IOWA 50273
JAMES M. HOCHSTETLER, 110 WEST GREEN ST., WINTERSET, IOWA 50273

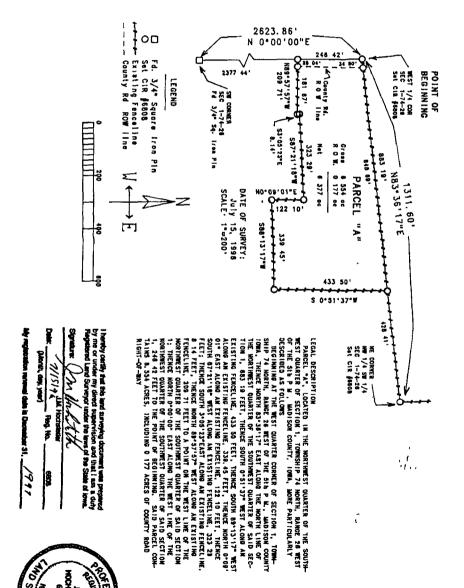

26 WEST OF THE 5th P.M., MADISON COUNTY, IOWA. A PLAT OF SURVEY FOR TOM EGLI IN THE NORTHWEST QUARTER OF THE SOUTHWEST QUARTER OF SECTION 1, TOWNSHIP 74 NORTH, RANGE

