



Document 2012 3831

Book 2012 Page 3831 Type 06 043 Pages 1  
Date 12/17/2012 Time 10:01 AM  
Rec Amt \$.00

INDX ✓  
ANNO  
SCAN  
CHEK

LISA SMITH, COUNTY RECORDER  
MADISON COUNTY IOWA

Prepared By: Michael James Hackett, Madison County Engineer's Office, 1105 E. Court Ave., Winterset, Ia. 50273, Tel. (515) 462-1136

# UNITED STATES PUBLIC LAND SURVEY CORNER CERTIFICATE OF


Land Survey Monuments situated in Section 27, Township 75 N, Range 29 W, of the Fifth Principal Meridian, Madison County, Iowa.  
Previously recorded in \_\_\_\_\_ in County Recorder's Office.  
(book, page, document number, etc.)

(Show reason for preparing this certificate, the evidence and detailed procedures used in establishing the corner positions and monumentation found or placed.)

Monument Description and Remarks: Found 1/2" rebar 15 inches deep in Madison County road. The corner position based traversing the south line of Southeast Quarter, the fence line to the north, and the Madison County Road Record Book B, Page 230, on file in the Madison County Engineers Office to to verify found location.  
Accepted position. This certificate was prepared because there was no corner certificate previously recorded.


## PLAN VIEW

(Show a minimum of three reference ties to durable physical objects, relevant monuments and physical conditions that will enable recovery of the corner.)

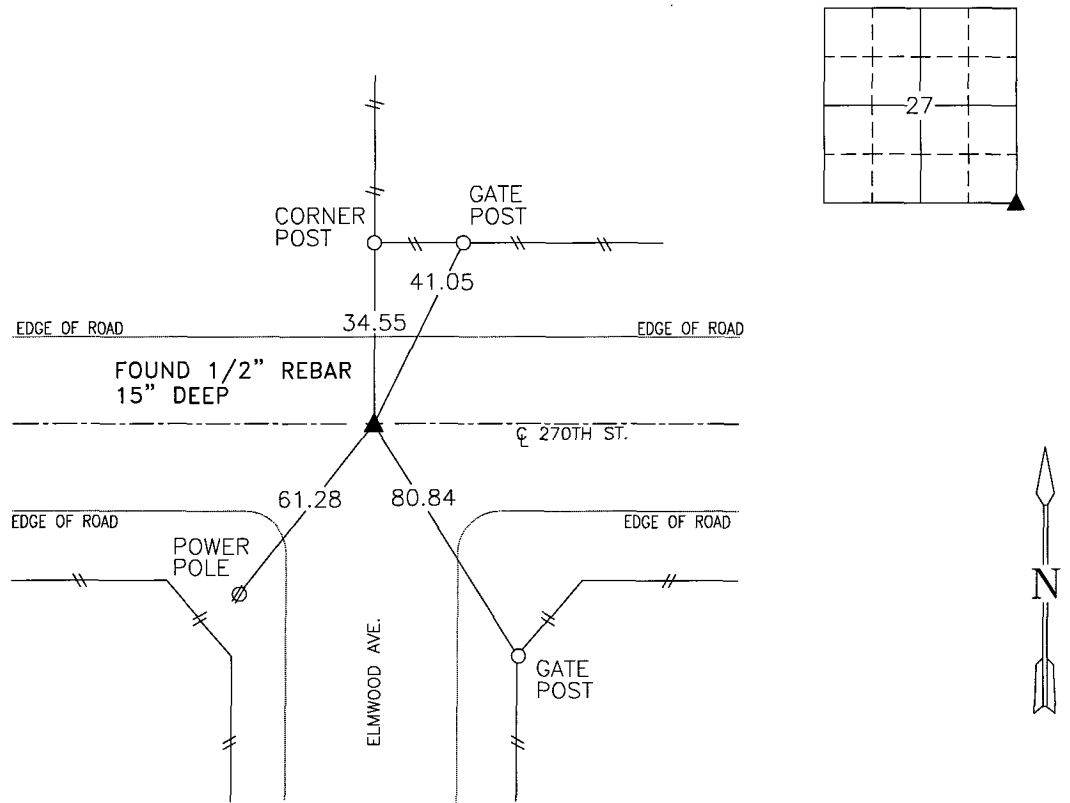

SE. COR., SE. 1/4 SEC. 27

NOTE: ALL TIES TO "X" NAILS UNLESS NOTED

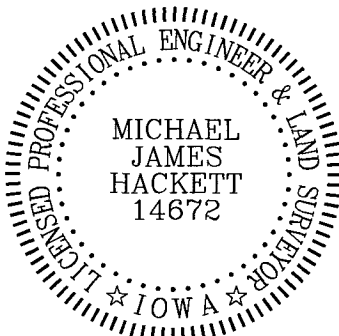

I hereby certify that this land surveying document was prepared and the related survey work was performed by me or under my direct personal supervision and that I am a duly Licensed Land Surveyor under the laws of the State of Iowa.

Signed Michael James Hackett Date 12/13/2012  
Michael James Hackett

Iowa license number 14672.  
My license renewal date is 12/31/2012.  
Pages covered by this seal: 1.