
Rec Amt \$7.00

Book 2013 Page 289 Type 06 026 Pages 1 Date 1/25/2013 Time 11:11 AM Time 11:11 AM

INDX **ANNO SCAN**

CHEK

LISA SMITH, COUNTY RECORDER MADISON COUNTY IOWA

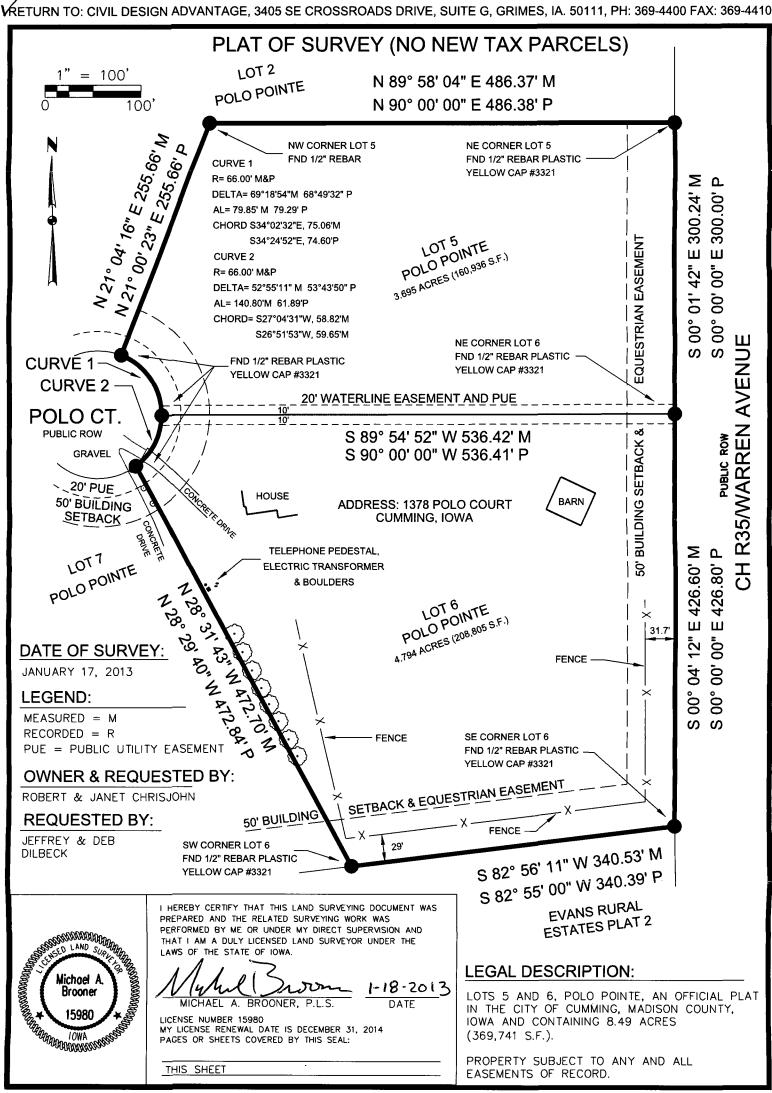

POLO POINTE **PLAT OF SURVEY**



3405 SE CROSSROADS DRIVE, SUITE G GRIMES, IOWA 50111 PH: (515) 369-4400 Fax: (515) 369-4410

CUMMING, IOWA CIVIL DESIGN ADVANTAGE 1-18-2013

MIKE B