



Document 2013 2144

Book 2013 Page 2144 Type 06 026 Pages 1

Date 7/19/2013 Time 3:17 PM

Rec Amt \$7.00

INDX

ANNO


SCAN

CHEK

LISA SMITH, COUNTY RECORDER
MADISON COUNTY IOWA

VANCE & HOCHSTETLER, P.C. CONSULTING ENGINEERS, WINTERSET, IOWA (515) 462-3995
CHARLES T. VANCE, 110 WEST GREEN ST., WINTERSET, IOWA 50273-1533
JAMES M HOCHSTETLER, 110 WEST GREEN ST., WINTERSET, IOWA 50273 - 1533


PLAT OF SURVEY IN THE NORTHWEST QUARTER OF THE SOUTHEAST QUARTER OF SECTION 2, TOWNSHIP 76 NORTH, RANGE 29 WEST OF THE 5TH P.M., MADISON COUNTY, IOWA.
OWNED BY: H.H.I., AN IOWA CORPORATION

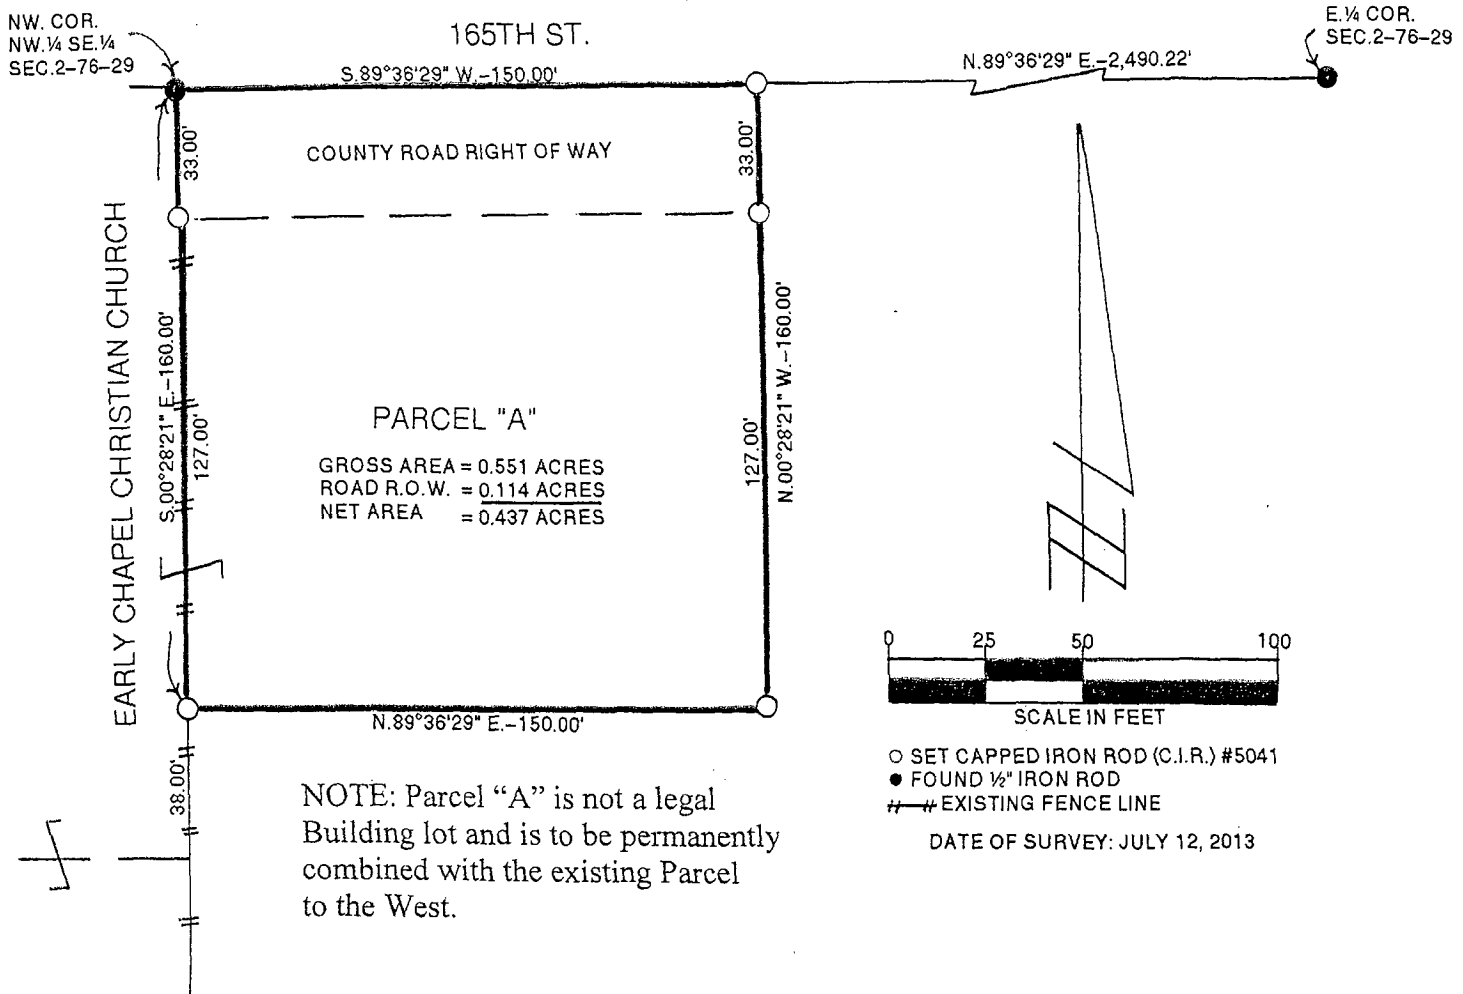

DESCRIPTION:

Parcel "A" in the Northwest Quarter of the Southeast Quarter of Section 2, Township 76 North, Range 29 West of the 5th P.M., Madison County, Iowa, more particularly described as follows:

Beginning at the Northwest Corner of the Northwest Quarter of the Southeast Quarter of Section 2, Township 76 North, Range 29 West of the 5th P.M., Madison County, Iowa; thence along a property line fence, also being the West line of said Northwest Quarter of the Southeast Quarter of Section 2, South 00°28'21" East, 160.00 feet; thence North 89°36'29" East, 150.00 feet; thence North 00°28'21" West, 160.00 feet to the North line of the Northwest Quarter of the Southeast Quarter of said Section 2; thence along said North line, South 89°36'29" West, 150.00 feet to the point of beginning and containing 0.551 Acres including 0.114 Acres of County Road Right of Way.

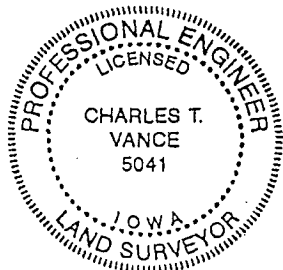

I hereby certify that this land surveying document was prepared and the related survey work was performed by me or under my direct personal supervision and that I am a duly Licensed Land Surveyor under the laws of the State of Iowa.

Charles T. Vance 19 July 2013
Charles T. Vance, PE & PLS Date

License No. 5041

My License renewal date is 31, December 2013