Document 2013 2890

Book 2013 Page 2890 Type 06 043 Pages 1
Date 9/27/2013 Time 2:59 PM
Rec Amt $7.00

INDX ✓
ANNO
SCAN

LISA SMITH, COUNTY RECORDER
MADISON COUNTY IOWA

CHEK

PREPARED BY: CRAIG S. BOLDMAN 521 WEST GREEN STREET,WINTERSET, IA 50273 PHONE (515)462-9242

UNITED STATES PUBLIC LAND SURVEY CORNER CERTIFICATE

Land Survey Monuments situated in Section 24, Township 75N, Range 28W, the Fifth Principal Meridian, Madison County, Iowa.
Previously recorded in None found in County Recorder's Office


(Show reason for preparing this certificate,the evidence and detailed procedures used in establishing the corner positions & monumentation found or placed)


Monument Description and Remarks:

Center SW $\frac{1}{4}$– Searched county for prior records. None found. Found ald fence post with wire and brace 1324' from found W $\frac{1}{4}$ SW $\frac{1}{4}$. Set $\frac{1}{2}$"orange capped iron rod at fence post.


PLAN–VIEW

CENTER SW 1/4

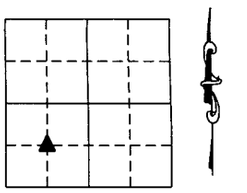

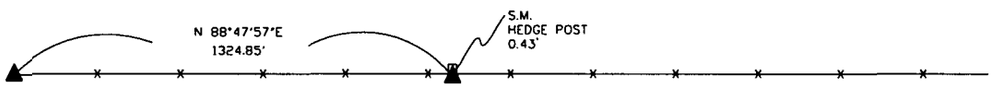



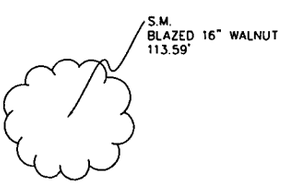

I HEREBY CERTIFY THAT THIS LAND SURVEYING DOCUMENT WAS PREPARED AND THE RELATED SURVEY WORK WAS PERFORMED BY ME OR UNDER MY DIRECT PERSONAL SUPERVISION AND THAT i AM A DULY LICENSED LAND SURVEYOR UNDER THE LAWS OF THE STATE OF IOWA.

SIGNATURE _____
CRAIG S. BOLDMAN

DATE: 9/27/13 LICENSE NO 13427

MY RENEWAL DATE IS DECEMBER 31, 2014

COVERS SHEETS 1

LICENSED LAND SURVEYOR
CRAIG S. BOLDMAN
LS 13427
IOWA

LIST CORNERS TO BE INDEXED

Corners	Section	Township	Range
CENTER SW 1/4	24	75	28