
Plat of a Survey made for Robert M. Casper in the NE¼ of the NE¼ of Section 36 Township 76 North, Range 28 West of the 5th P.M., City of Winterset, Madison County, Iowa.

1286

FILED NO. _____
BOOK 1 PAGE 231

1975 SEP 16 AM 11:38

MARY E. WELTY
RECORDER
MADISON COUNTY, IOWA
Fee 2 50

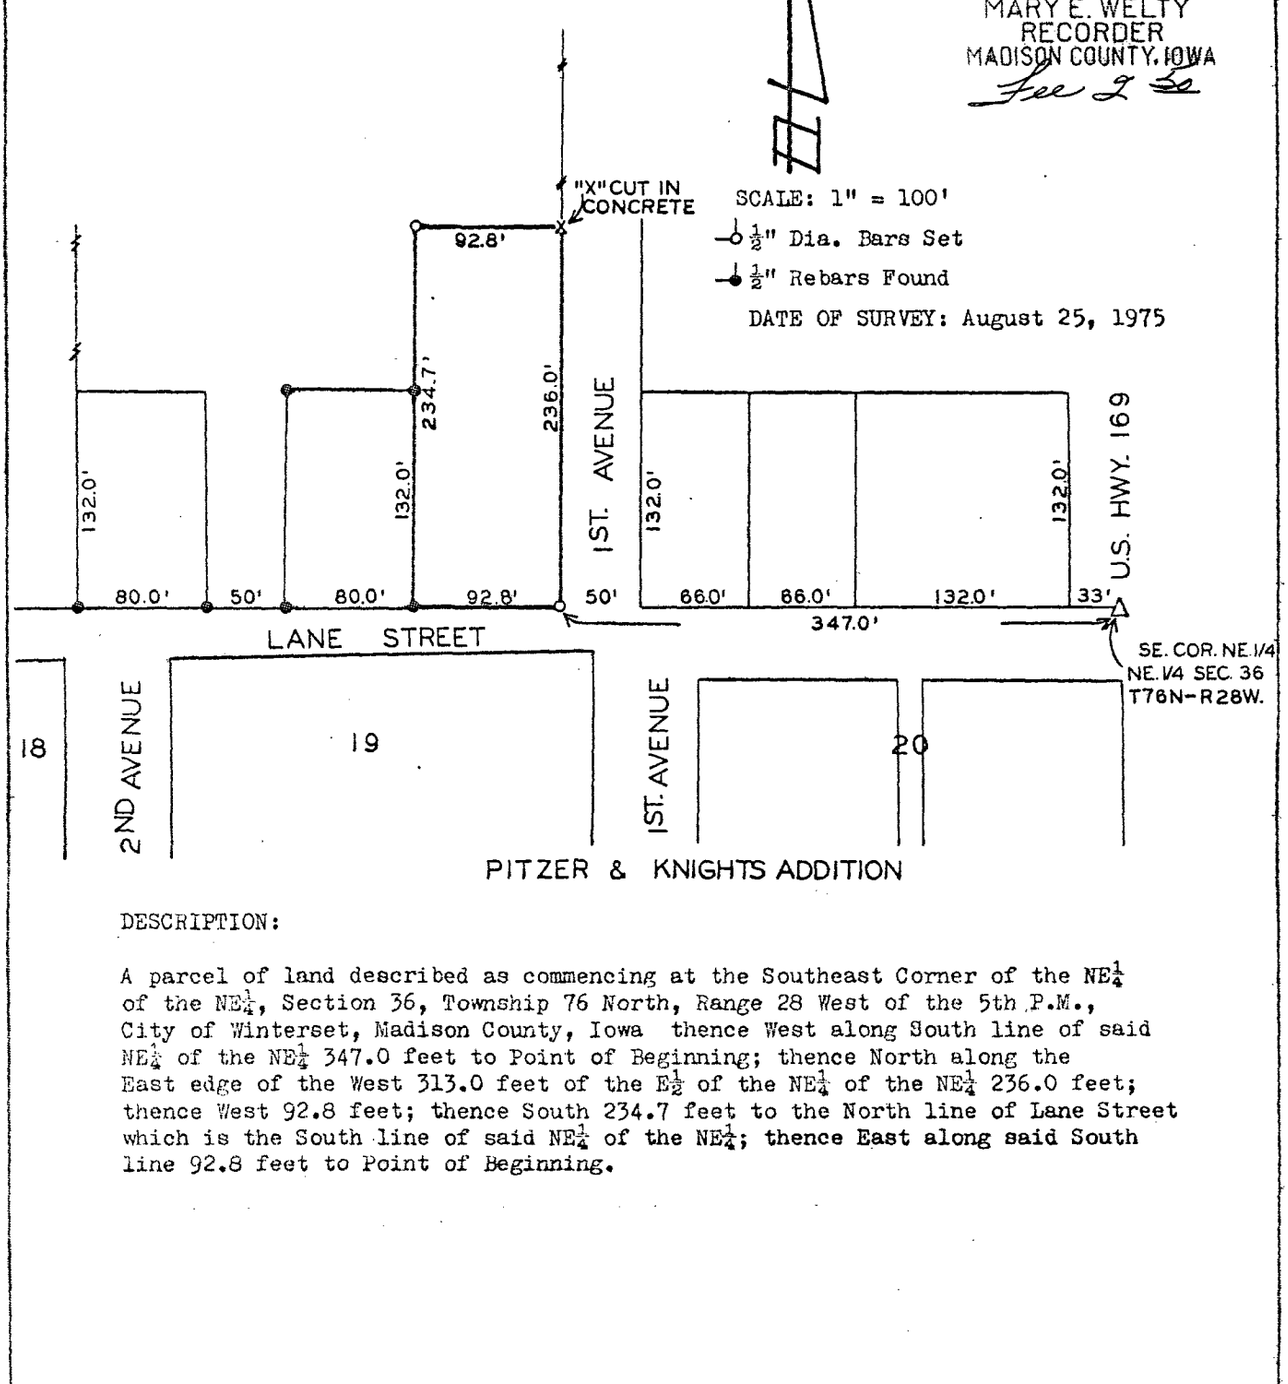

DESCRIPTION:

A parcel of land described as commencing at the Southeast Corner of the NE¼ of the NE¼, Section 36, Township 76 North, Range 28 West of the 5th P.M., City of Winterset, Madison County, Iowa thence West along South line of said NE¼ of the NE¼ 347.0 feet to Point of Beginning; thence North along the East edge of the West 313.0 feet of the E½ of the NE¼ of the NE¼ 236.0 feet; thence West 92.8 feet; thence South 234.7 feet to the North line of Lane Street which is the South line of said NE¼ of the NE¼; thence East along said South line 92.8 feet to Point of Beginning.

I hereby certify that this plat, map, survey or report was made by me or under my direct personal supervision and that I am a duly registered Land Surveyor under the laws of the State of Iowa

Signed J. M. Hochstetler Date Aug 29 '75

J M Hochstetler, P.E., L.S. Iowa Reg. No. 6808

VANCE & HOCHSTETLER
CONSULTING ENGINEERS

WINTERSET, IOWA