Document 2013 3629

Book 2013 Page 3629 Type 06 043 Pages 1
Date 12/03/2013 Time 3:37 PM
Rec Amt $7.00

INDX ✓
ANNO
SCAN

LISA SMITH, COUNTY RECORDER
MADISON COUNTY IOWA

CHEK

VANCE & HOCHSTETLER, P.C. CONSULTING ENGINEERS, WINTERSET, IOWA (515)462-3995
CHARLES T. VANCE, 110 WEST GREEN ST., WINTERSET, IOWA 50273
JAMES M. HOCHSTETLER, 110 WEST GREEN ST., WINTERSET, IOWA 50273

UNITED STATES PUBLIC LAND SURVEY CORNER CERTIFICATE

OF


Land Survey Monuments situated in Section 7, Township 75 North, Range 27 West, of the Fifth Principal Meridian, Madison County, Iowa.
Previously recorded in N/A (book, page, document number, etc.) in County Recorder's Office.


(Show reason for preparing this certificate, the evidence and detailed procedures used in establishing the corner positions and monumentation found or placed.)

Monument Description and Remarks: Set Yellow C.I.R. #5041 on the Quarter Section Line at distance 1320.00 feet from the certified Center Corner of fractional Section 7, T75N, R27W of the 5th P.M., and intersected it with the ¼ ¼ Section Line from the SW. Corner of the SE.¼ of the SW ¼ of said section 7.

PLAN - VIEW

(Show a minimum of three reference ties to durable physical objects, relevant monuments and physical conditions that will enable recovery of the corner.)

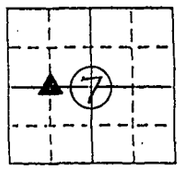

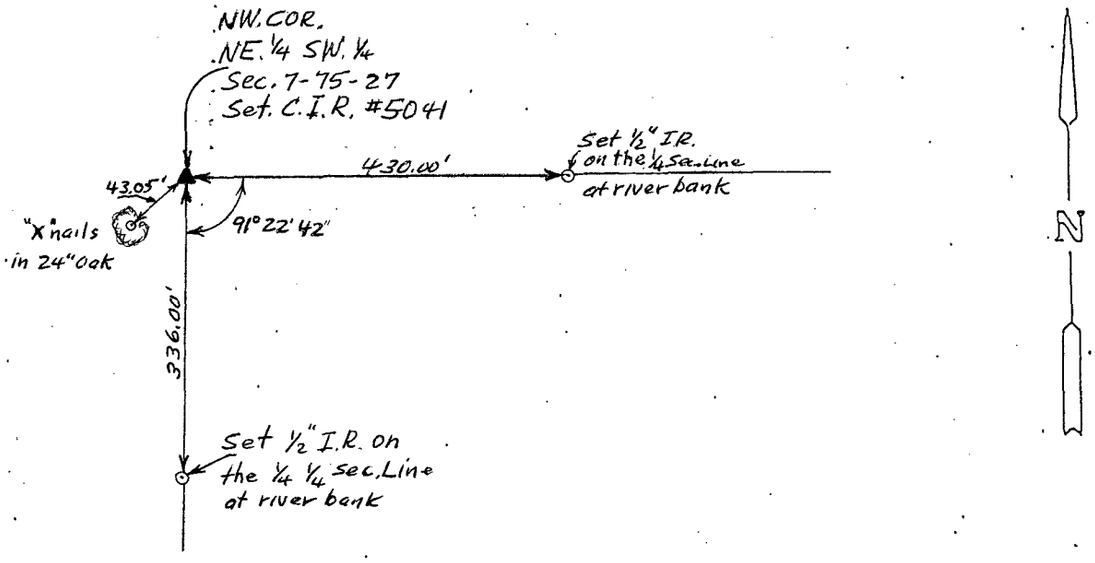

Ref. to NW. Cor. of the Northeast Quarter of the Southwest Quarter of Frac. Sec. 7, T75N, R27W.

I hereby certify that this land surveying document was prepared and the related survey work was preformed by me or under my direct personal supervision and that I am a duly Licensed Land Surveyor under the laws of the State of Iowa.

Charles T. Vance 14 Oct 2013
Charles T. Vance, PE & PLS — Date

License No. 5041

My License renewal date is 31, December 2013

PROFESSIONAL ENGINEER LICENSED CHARLES T. VANCE 5041 IOWA LAND SURVEYOR

List Corners to be Indexed

Corners	Section	Twp	Range
NW. Cor. NE.¼ SW.¼	7	75	27