
[redacted]

FILED NO. 98
BOOK 1 PAGE 83
1972 JAN 27 PM 1:43
MARY E. WELTY
RECORDER
MADISON COUNTY, IOWA
Fee $2.50

LEGAL DESCRIPTION:

The North 48' of Lot 3, all of Lot 4, and the South 36' of Lot 5, Block 4, Taylors Addition, an Official Plat now being in and forming a part of the Town of Earlham, Madison County, Iowa.

o - Indicates Iron Rod Set

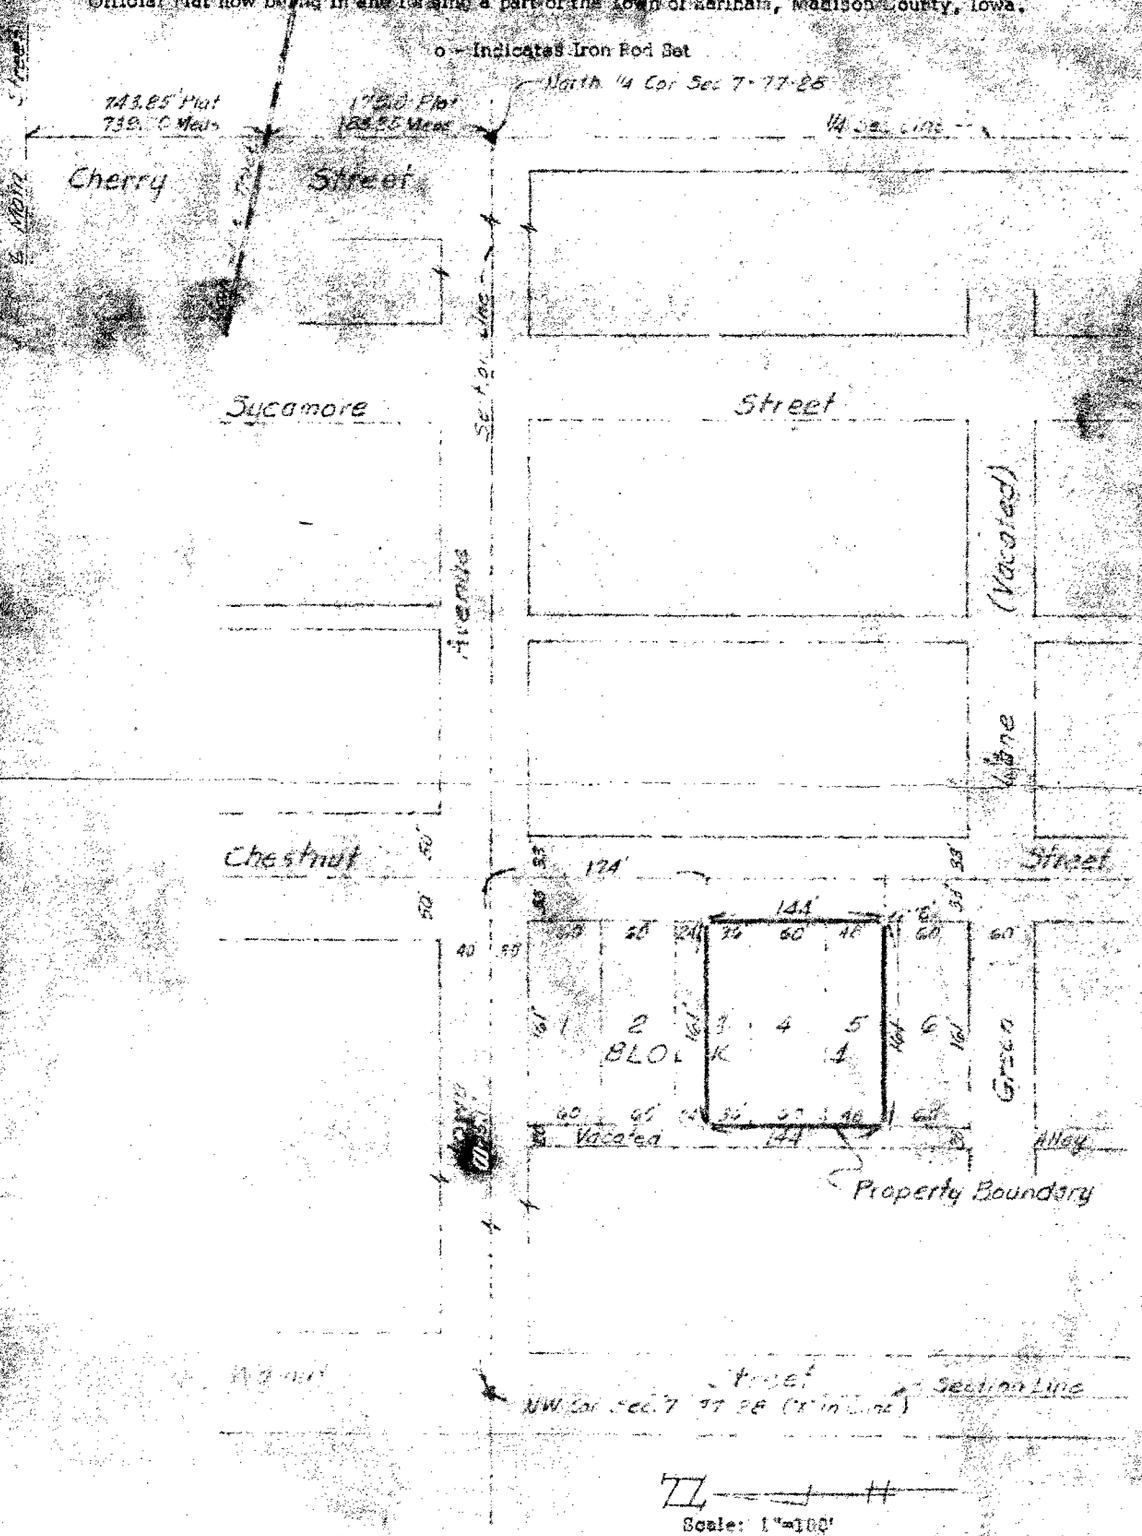

CERTIFICATION:

I hereby certify that this plat and survey was made by me, or under my direct personal supervision, and that I am a duly registered Land Surveyor under the Laws of the State of Iowa.

DUANE C. GOLLAND, Consulting Engineer

[redacted] September 1, 1971

Reg. LS #4683

326 E. Miller, Des Moines, Iowa 50315

DUANE C. GOLLAND REGISTERED LAND SURVEYOR 4683 IOWA

Drawing B016
W. O. No. 151