
PLAT FOR G. J. Leuty DATE 5-3-77

SEC. 6 TWP. 77 N. R. 28 W. OF 5th P.M.

Parcel "A": Beginning at a point 1208.81 feet west and 336 feet North of the center Sec. 6-77-28, thence North 126.0 feet, thence East 313.91 feet, thence South 126.0 feet, thence West 313.91 feet to the point of beginning, containing 0.908 Acres.

Parcel "B": Beginning at a point 1208.81 feet west and 215 feet north of the center Sec 6-77-28, thence North 121.0 feet, thence East 160.91 feet, thence South 121.0 feet, thence West 160.91 feet to the point of beginning, containing 0.447 Acres.

Parcel "C": Beginning at a point 1208.81 feet west and 33 feet North of the center Sec 6-77-28, thence North 182.0 feet, thence East 160.91 feet, thence South 182.0 feet, thence West 160.91 feet to the point of beginning containing 0.672 Acres.

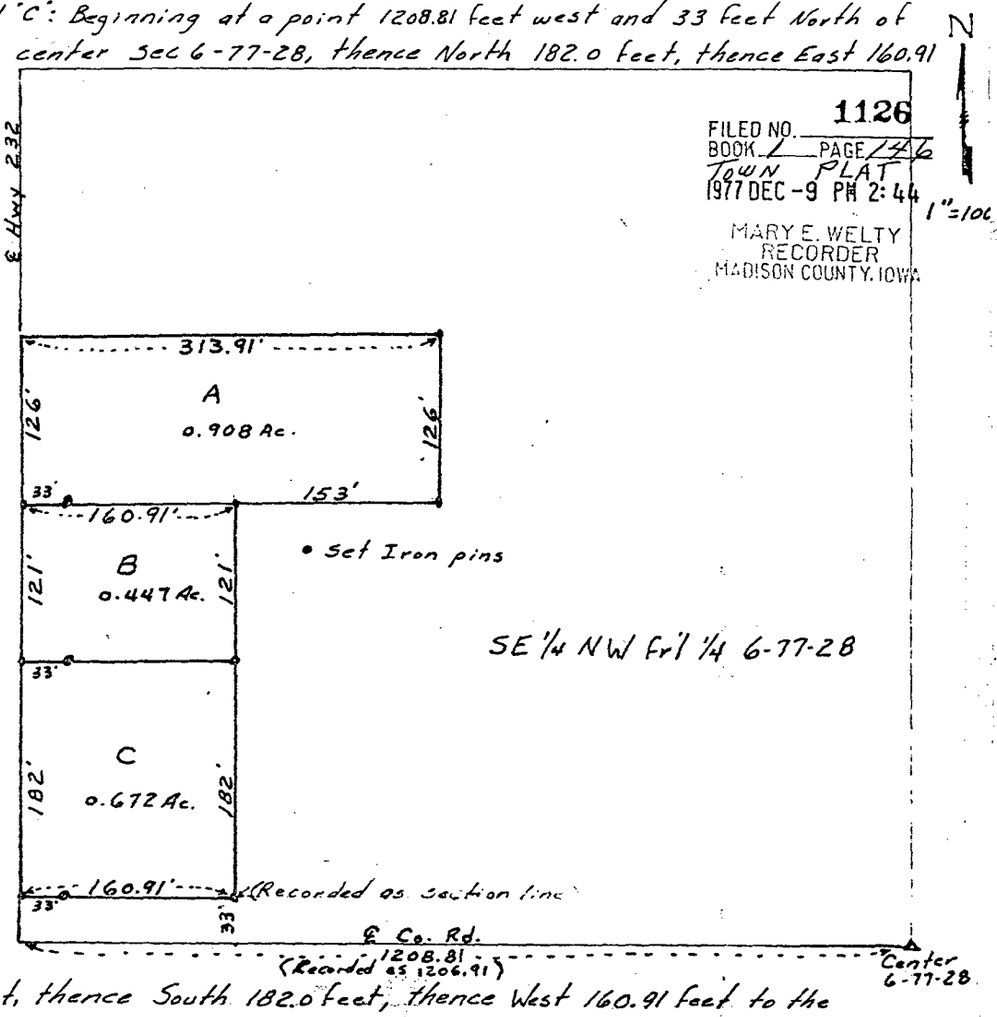

I HEREBY CERTIFY THAT THIS PLAT, SURVEY OR REPORT WAS MADE BY ME OR UNDER MY DIRECT PERSONAL SUPERVISION AND THAT I AM A DULY REGISTERED LAND SURVEYOR UNDER THE LAWS OF THE STATE OF IOWA.

Gene E. Hardy, PE & LS #3374

DATE 5-3-77