
copy

Plat of a Survey made for Mr. & Mrs. Norman McIntyre of

Lot 2, 3 & 4 of Block 8, Wilson's Addition

Town of Earlham, Madison County, Iowa

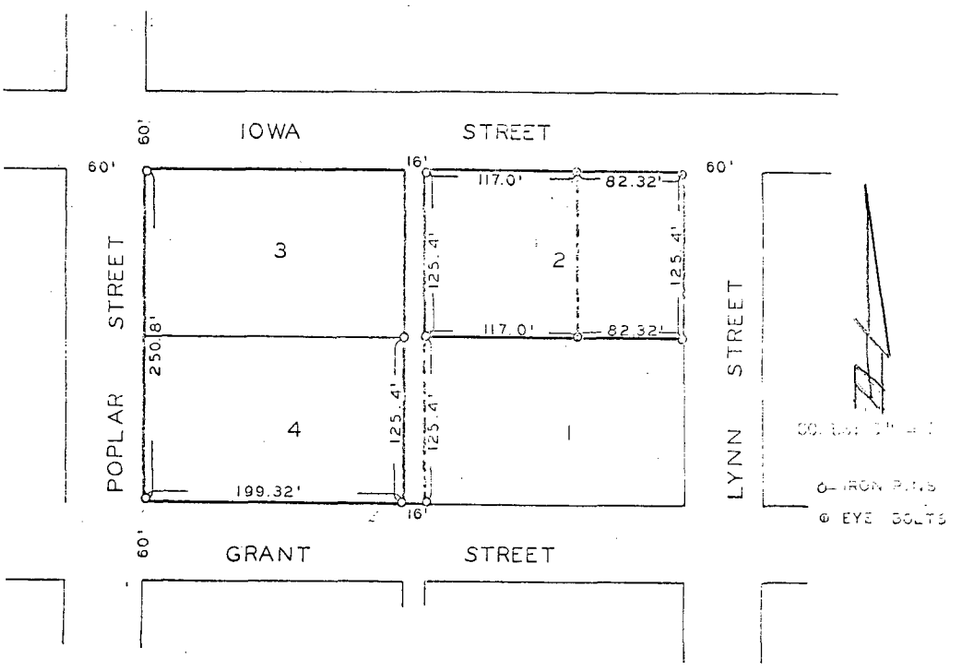

FILED NO. 1036
BOOK 1 PAGE 87
1974 JUN 27 AM 9:59
MARY E. WELTY
RECORDER
MADISON COUNTY, IOWA

I hereby certify that this plan, specification, plat, map, survey or report was made by me or under my direct personal supervision and that I am a duly registered Professional Engineer and Land Surveyor under the laws of the State of Iowa.

Signed J. M. Hochstetler Date July 6 19 73

J. M. HOCHSTETLER, P. E., L.S. Iowa Reg. No. 6808

VANCE & HOCHSTETLER
CONSULTING ENGINEERS
WINTERSET, IOWA