
PLAT OF A SURVEY MADE FOR THE CITY OF EARLHAM IN BLOCK 13 OF THE ORIGINAL TOWN OF EARLHAM, MADISON COUNTY, IOWA AND THE ADJOINING RAILROAD STATION GROUNDS.

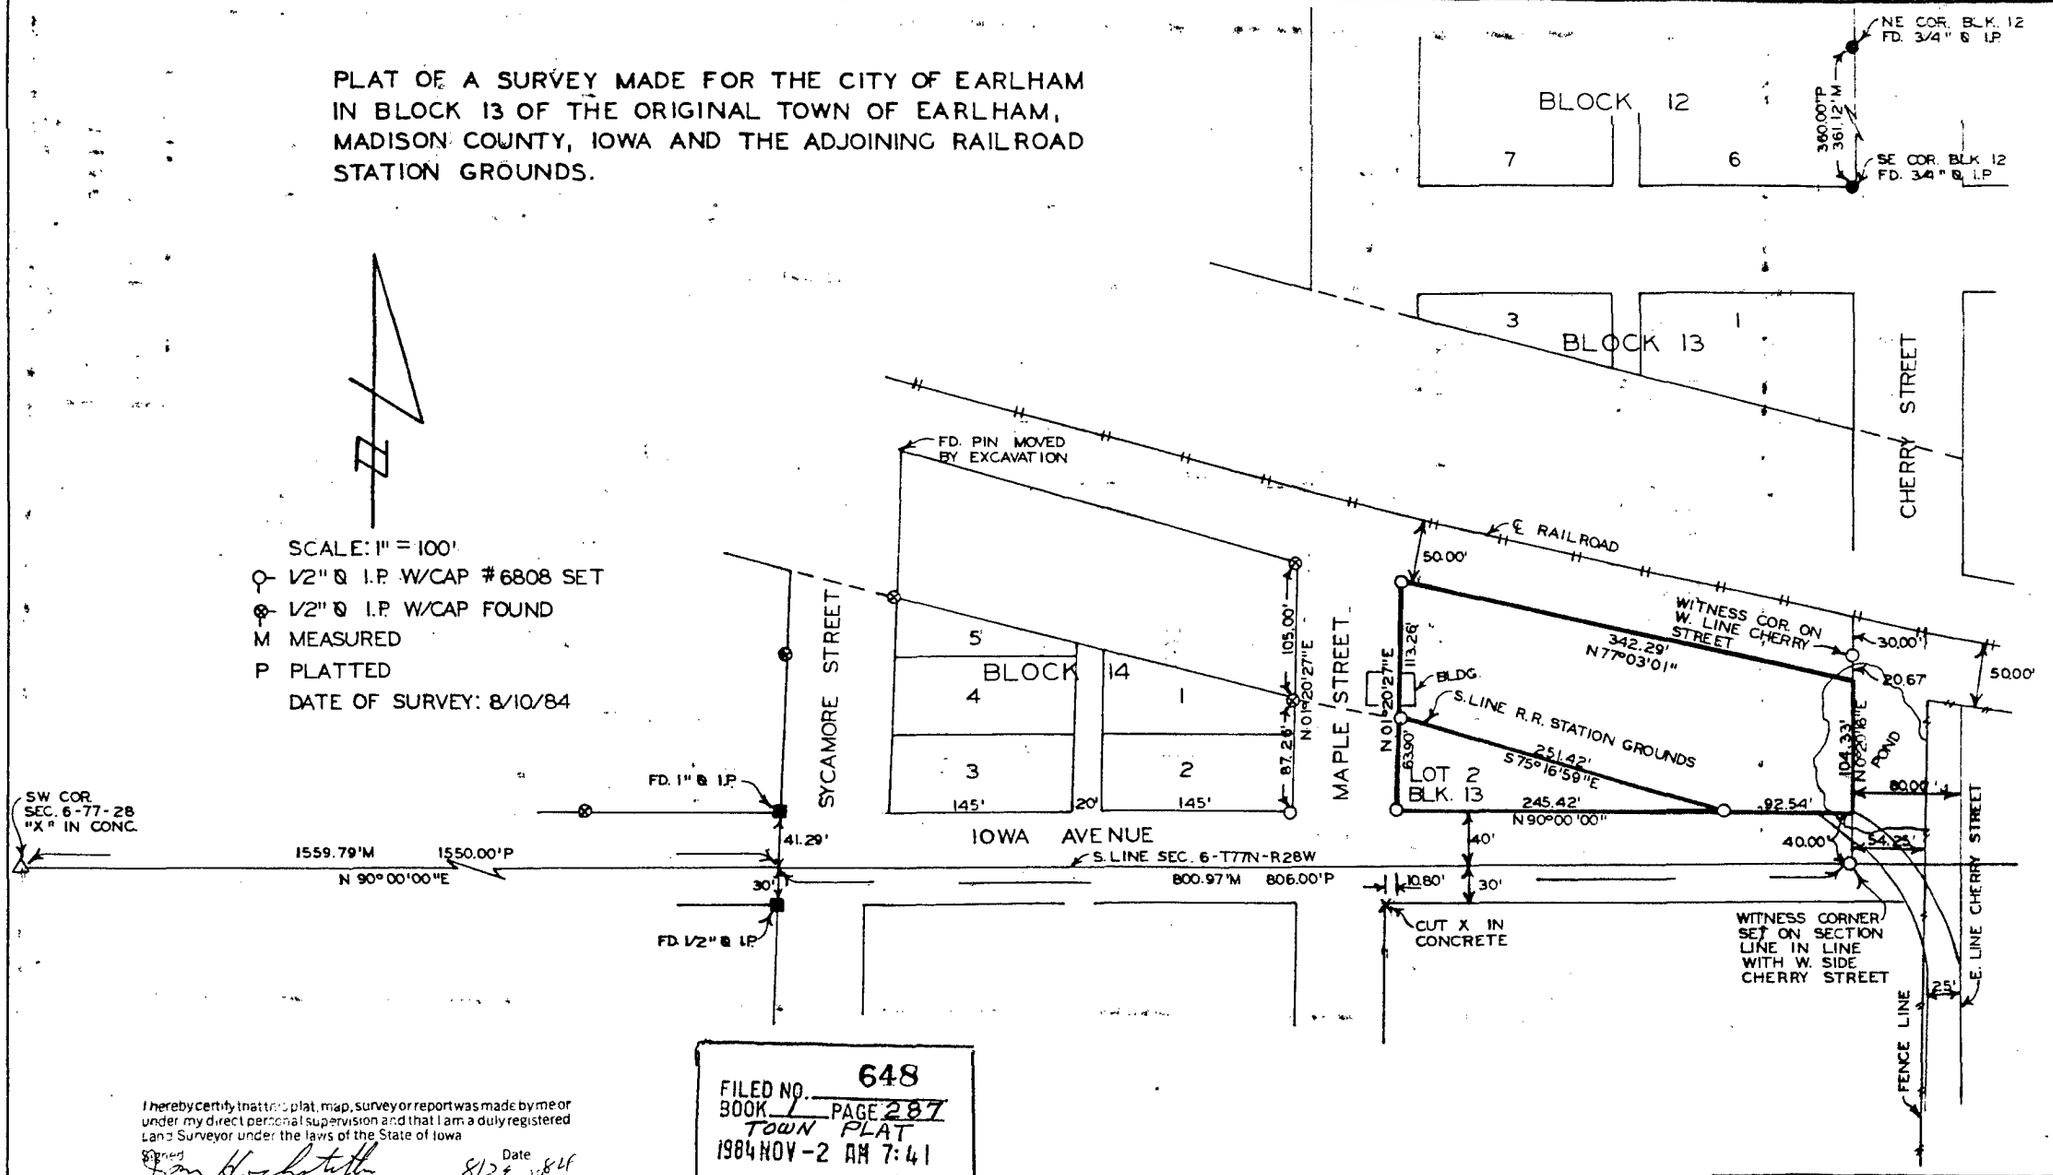

SCALE: 1" = 100'

- ⊙ 1/2" Ø I.P. W/CAP #6808 SET
- ⊗ 1/2" Ø I.P. W/CAP FOUND
- M MEASURED
- P PLATTED

DATE OF SURVEY: 8/10/84

I hereby certify that this plat, map, survey or report was made by me or under my direct personal supervision and that I am a duly registered Land Surveyor under the laws of the State of Iowa

Signed Jon Hochstetler Date 8/24 1984

Jon Hochstetler P.E. L.S. Iowa Reg. No. 6808

FILED NO. 648
BOOK 1 PAGE 287
TOWN PLAT
1984 NOV -2 AM 7:41
MARY E. WELTY
RECORDER
MADISON COUNTY, IOWA
Fee $5.00

VANCE & HOCHSTETLER, P.C.
71 JEFFERSON ST.
WINTERSET, IOWA 50273