

PLAT OF SURVEY FOR CAROL HARPER OF LOT 4, BLOCK 6, ORIGINAL TOWN OF PATTERSON, IOWA

FILED NO. 1770
BOOK 1 PAGE 266
Town PLAT
1983 MAY -3 PM 3:50
MARY E. WELTY
RECORDER
MADISON COUNTY, IOWA
Fee 3.00

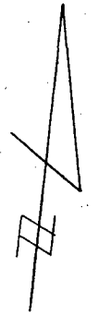

SCALE: 1" = 50'

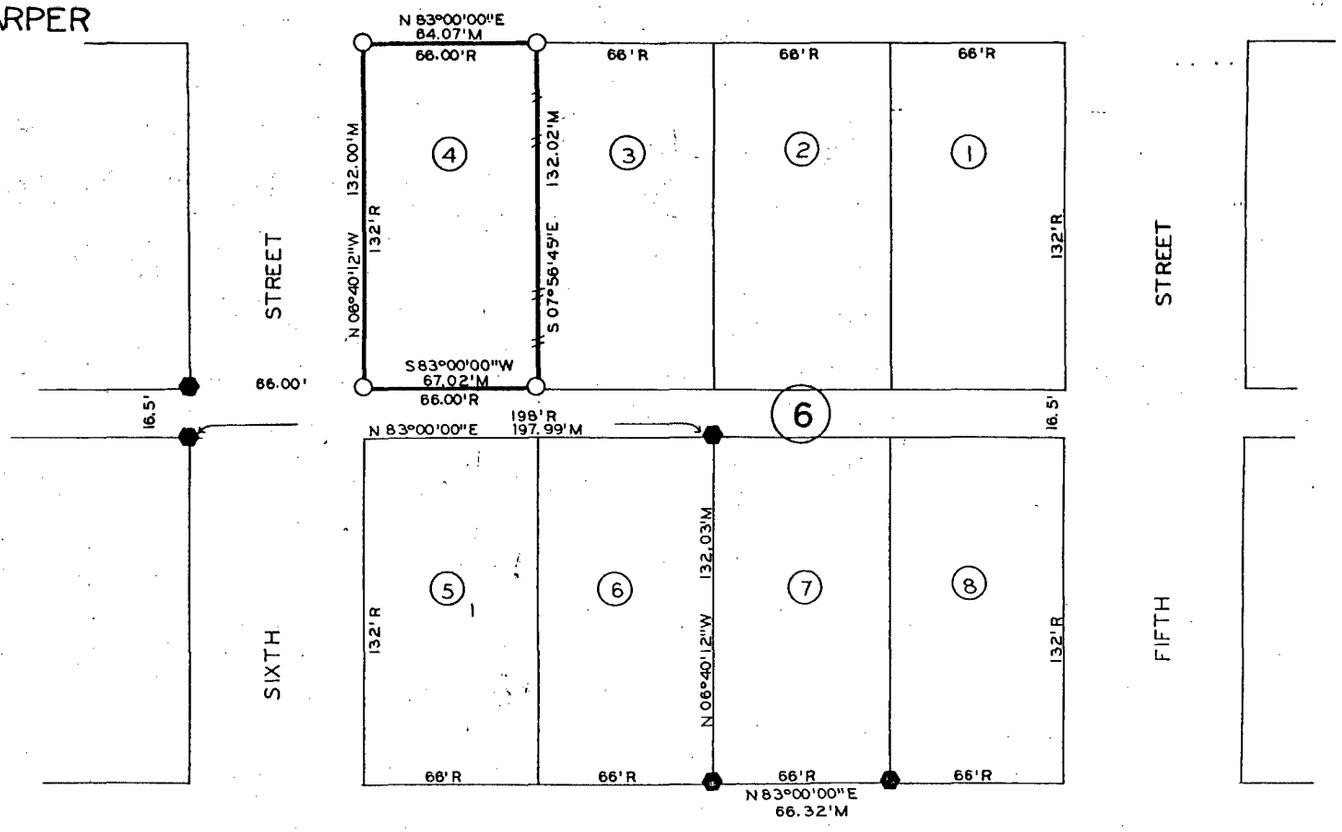

LEGEND

- ⬢ FOUND C.I.R. #6808
- O SET C.I.R. #8034
- —//—//— OLD EXISTING FENCE
- R RECORDED DISTANCE
- M MEASURED DISTANCE

NOTE: BEARINGS ARE BASED ON THE S. LINE OF BLOCK 6, WHICH IS ASSUMED TO BEAR N83°00'00"E.

REGISTERED LAND SURVEYOR
REGISTERED
8034
CLEO E.
McCALL
IOWA

I hereby certify that this plat, map, survey or report was made by me or under my direct personal supervision and that I am a duly registered Land Surveyor under the laws of the State of Iowa.

Signed Cleo E. McCall Date 3-11 19 83

CLEO E. McCALL, R.L.S. IOWA REG. NO. 8034

VANCE & HOCHSTETLER, P.C.
CONSULTING ENGINEERS
WINTERSET, IOWA 50273