
Plat of a Survey made for Hugh A. Maine of Lot 4, Block 8,
Hartman & Young Addition to St. Charles, Madison County, Iowa.

1093

FILED NO.
BOOK 1 PAGE 230
Town Plat
1975 AUG -8 AM 11:26

MARY E. WELTY
RECORDER
MADISON COUNTY, IOWA
Fee $ 50

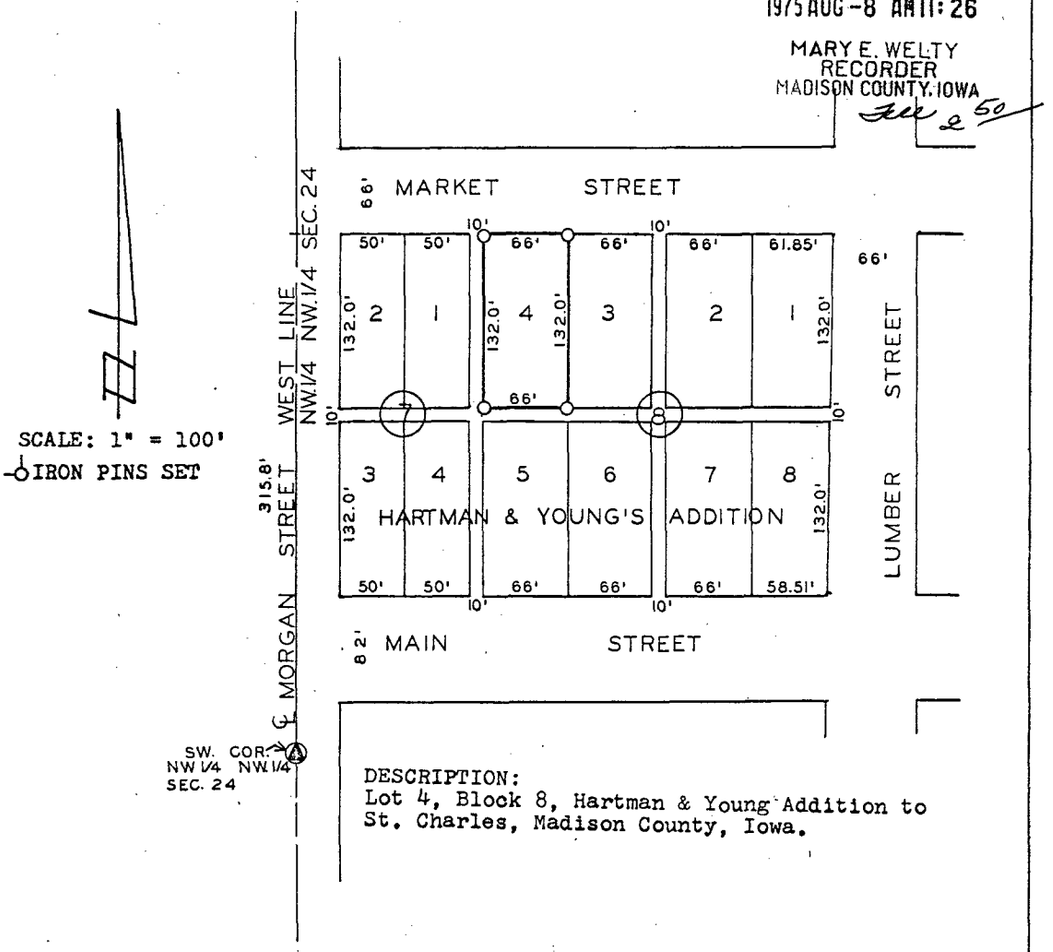

DESCRIPTION:
Lot 4, Block 8, Hartman & Young Addition to St. Charles, Madison County, Iowa.

I hereby certify that this plat, map, survey or report was made by me or under my direct personal supervision and that I am a duly registered Land Surveyor under the laws of the State of Iowa.

Signed
J M Hochstetler, P.E., L.S. Iowa Reg No 6808

Date 8/5 1975

VANCE & HOCHSTETLER
CONSULTING ENGINEERS
WINTERSET, IOWA