
SURVEY FOR LESTER P. AND SHERYL L. MATLAGE

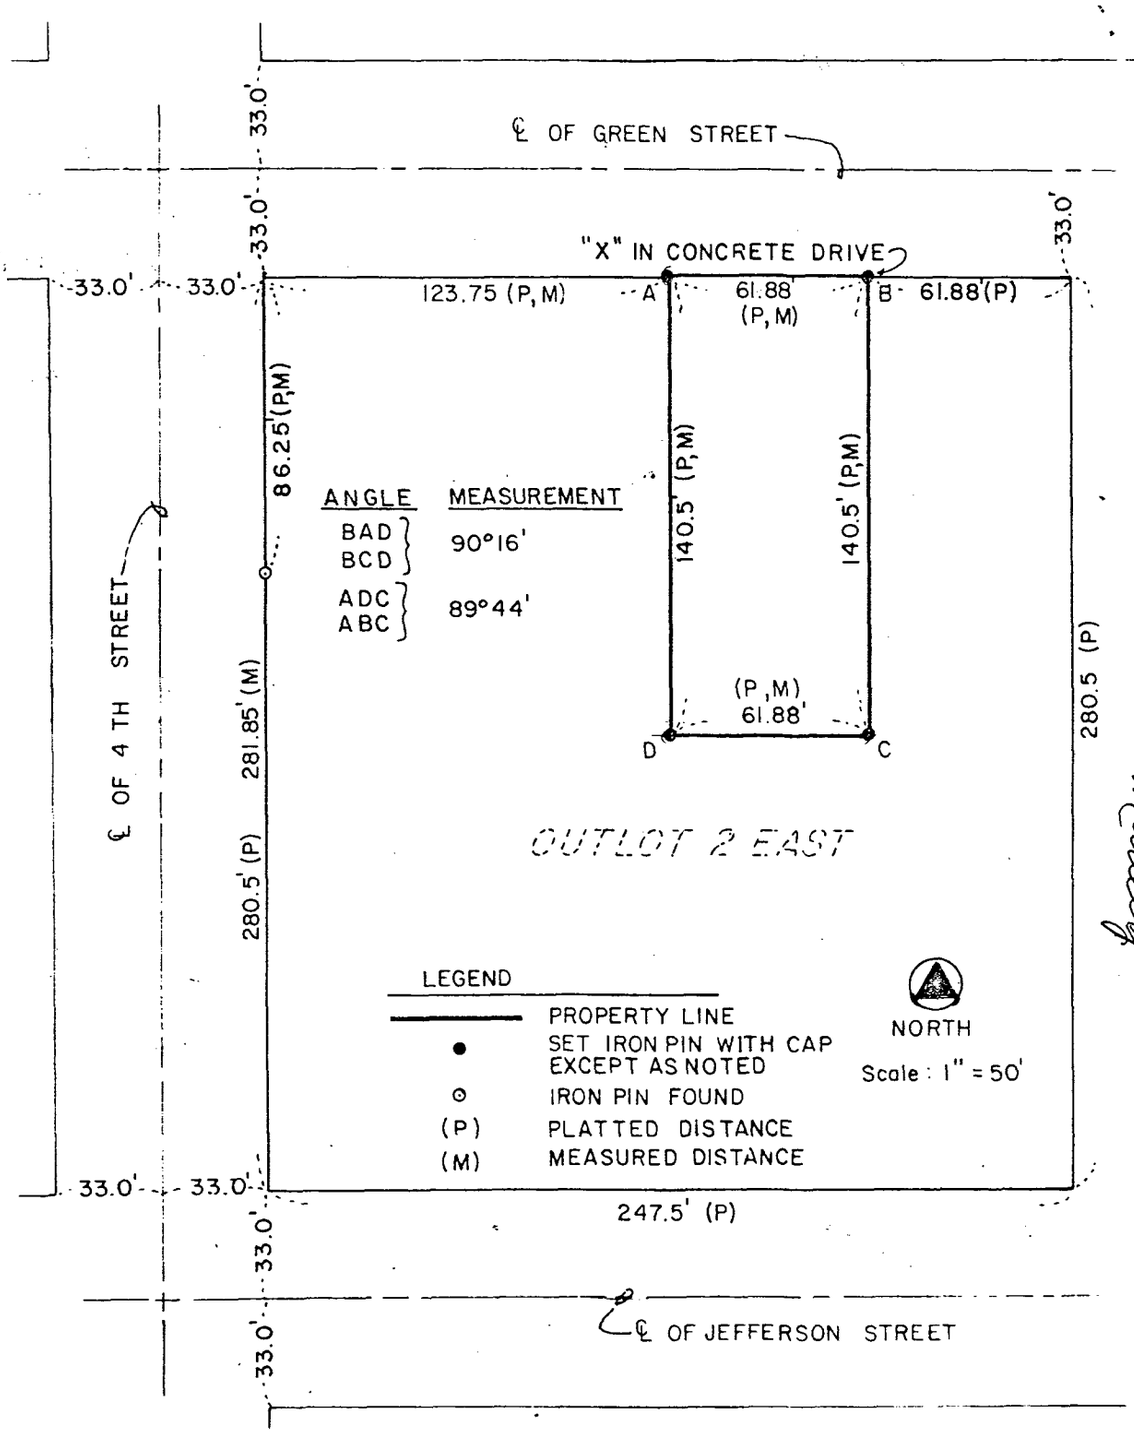

STATE OF IOWA, MADISON COUNTY, ss.
Town Plat Book 1 Page 254 Inst. No. 316
Filed for Record this 26 day of August 19 81 at 10:57 A.M.
Recording Fee 3.00 Mary E. Welty, Recorder, By Deputy

NOTE: LESTER P. MATLAGE IS LESTER P. MATLAGE, JR.

PROPERTY DESCRIPTION

THE NORTH 140½ FEET OF THE WEST HALF OF THE EAST HALF OF OUTLOT TWO OF EAST ADDITION OF OUTLOTS TO THE ORIGINAL TOWN OF WINTERSET, IOWA.

CERTIFICATION

I, TEDDE R. BLUNCK, REGISTERED ENGINEER AND LAND SURVEYOR IN THE STATE OF IOWA, HEREBY CERTIFY THAT ON AUGUST 1, 1981 I SURVEYED THE ABOVE DESCRIBED PROPERTY FOR LESTER P. AND SHERYL L. MATLAGE, WINTERSET, IOWA AND THAT THIS PLAT WAS PREPARED FROM THE FIELD NOTES OF SAID SURVEY.

SIGNED _____ DATED August 18, 1981
TEDDE R. BLUNCK, P.E. & L.S. IOWA REGISTRATION NUMBER 7044