
Plat of a Survey made for Mary Griffith of Lot 5, Block 5, Original Town of Winterset, Iowa.

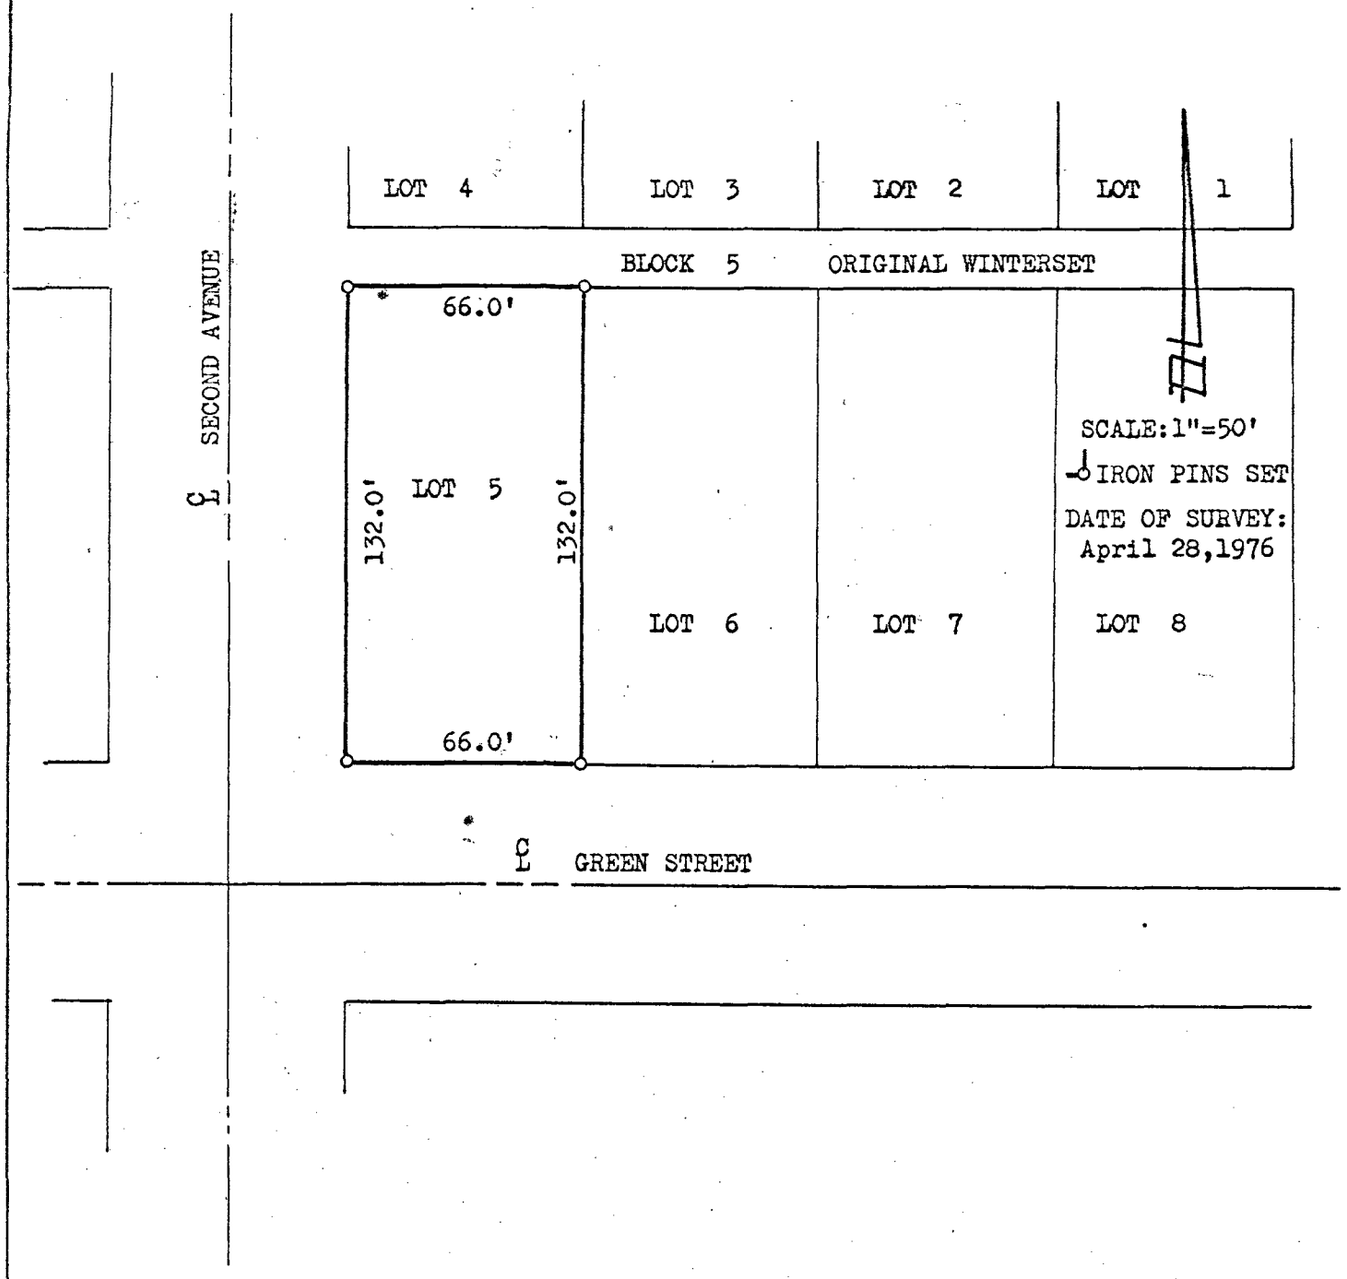

DESCRIPTION:

Lot 5 of Block 5, Original Town of Winterset, Iowa.

FILED NO. 2688
BOOK 1 PAGE 233
Town Plat
1976 MAY 10 AM 9:20
MARY E. WELTY
RECORDER
MADISON COUNTY, IOWA
Fee $2.50

I hereby certify that this plat, map, survey or report was made by me or under my direct personal supervision and that I am a duly registered Land Surveyor under the laws of the State of Iowa.

Signed J. M. Hochstetler Date May 7 1976

J. M. Hochstetler, P.E., L.S. Iowa Reg. No. 6808

VANCE & HOCHSTETLER
CONSULTING ENGINEERS
WINTERSET, IOWA