
PLAT OF A SURVEY MADE FOR GARY MATHES IN BLOCK 3, JENKIN'S ADDITION TO WINTERSET, IOWA.

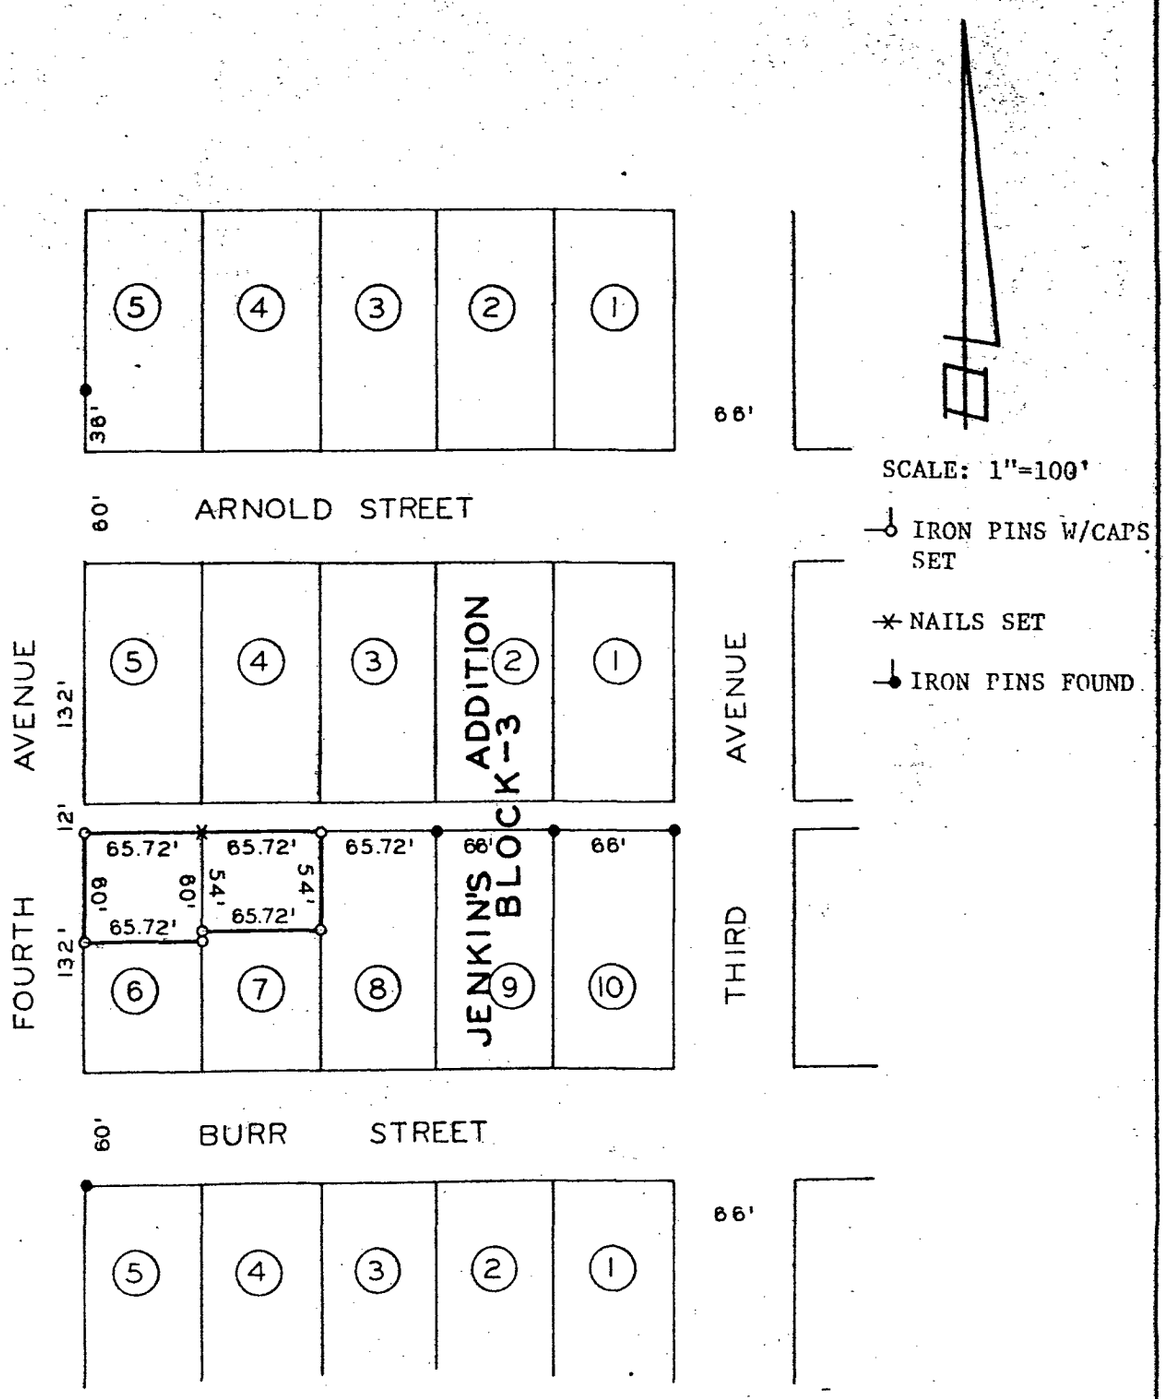

DESCRIPTION:

The North 60 feet of Lot Six (6) and the North 54 feet of Lot Seven (7) in Block Three (3) of Jenkin's Addition to the City of Winterset, Madison County, Iowa.

I HEREBY CERTIFY THAT THIS PLAN, SPECIFICATION, PLAT, MAP, SURVEY OR REPORT WAS MADE BY ME OR UNDER MY DIRECT PERSONAL SUPERVISION AND THAT I AM A DULY REGISTERED PROFESSIONAL ENGINEER AND LAND SURVEYOR UNDER THE LAWS OF THE STATE OF IOWA.

SIGNED Charles T. Vance

Charles T. Vance, P.E. & L.S.

DATE Nov. 7, 1978

Iowa Reg. No. 5041

FILED NO 981
BOOK 1 PAGE 245
TOWN PLAT
1978 NOV -7 PM 4:30

MARY E. WELTY
RECORDER
MADISON COUNTY, IOWA
Fee 3 00

VANCE & HOCHSTETLER, P.C.
CONSULTING ENGINEERS
WINTERSET, IOWA