
STATE OF IOWA, MADISON COUNTY, ss. Inst. No. 1914 Filed for Record this 29 day of June 1982 at 11:45 A.M.
Book 1 Page 259 Recording Fee 3.00 Mary E. Welty, Recorder. By _____ Deputy
Town Plat

# PLAT OF SURVEY FOR CARROLL & HELEN HAYDEN OF LOTS 3 AND 6, BLOCK 1, CLANTON's ADDITION ST. CHARLES, IOWA

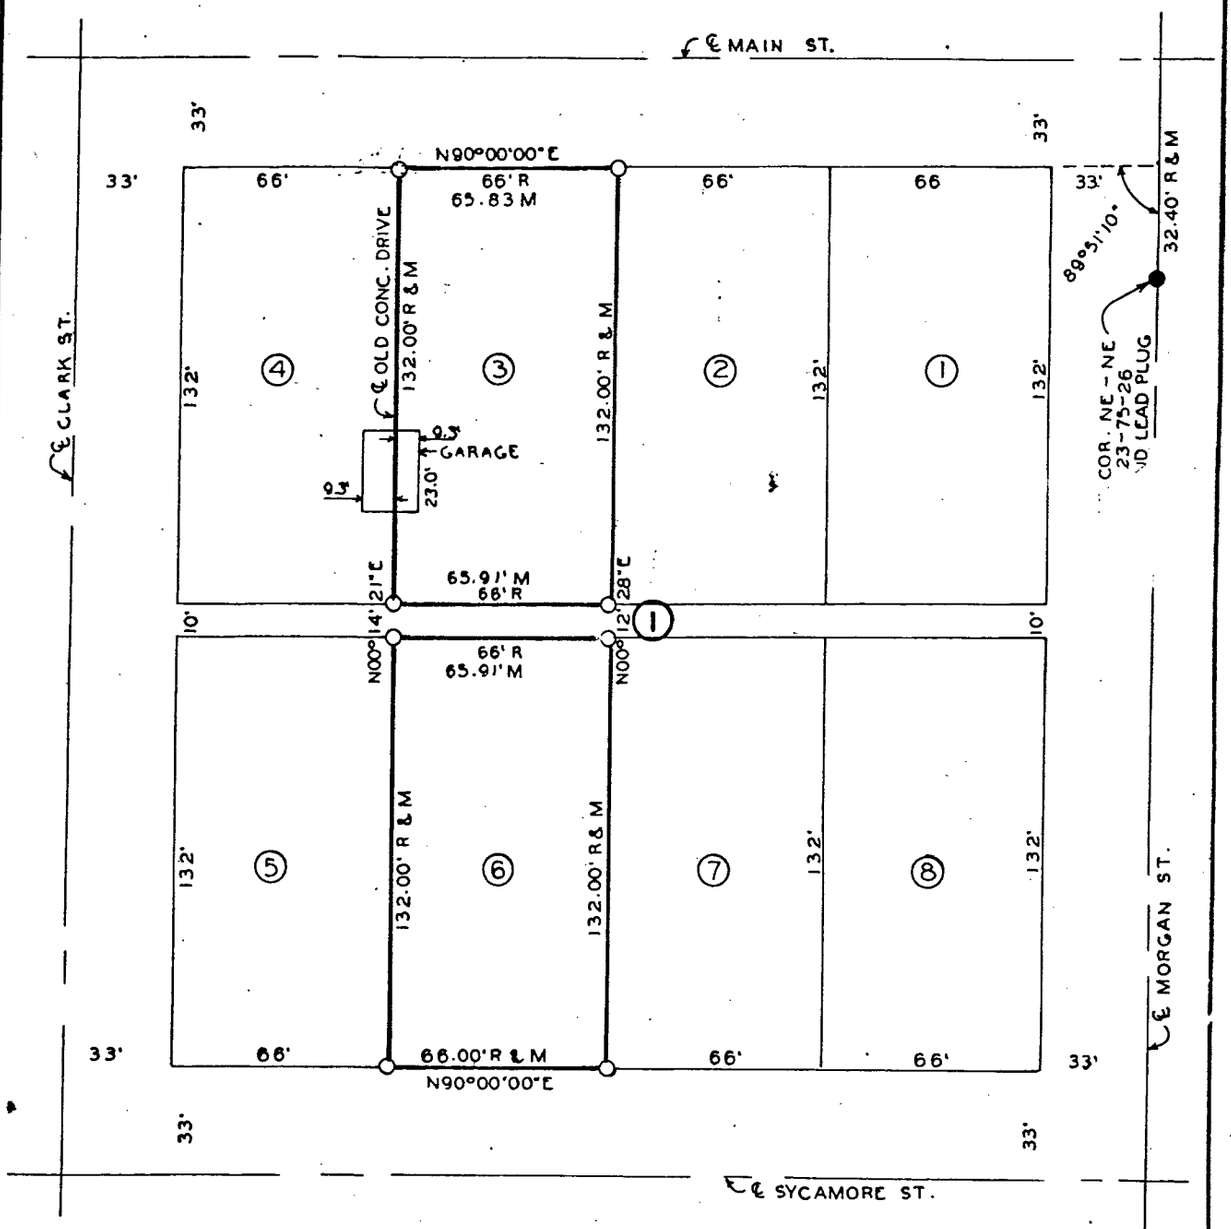


SCALE: 1"=50'

O SET C.I.R. #8034

R RECORDED DISTANCE

M MEASURED DISTANCE

REGISTERED LAND SURVEYOR
REGISTERED
8034
CLEO E.
McCALL
IOWA

I hereby certify that this plat, map, survey or report was made by me or under my direct personal supervision and that I am a duly registered Land Surveyor under the laws of the State of Iowa.

Signed Cleo E. McCall Date 6-14 1982

CLEO E. McCALL, R.L.S. IOWA REG. NO. 8034

VANCE & HOCHSTETLER, P.C.
CONSULTING ENGINEERS
WINTERSET, IOWA